
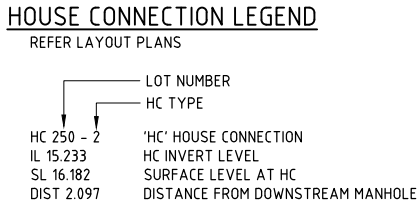
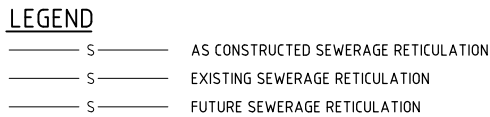


Plot Date: 4/07/2018 2:55:33 PM User: ETHAN SCHAEER-SRW\Name\_C:\pwworking\urbex\2014\civil-drawings\4.4.as con\B00176-AS CON-3.3-SEW

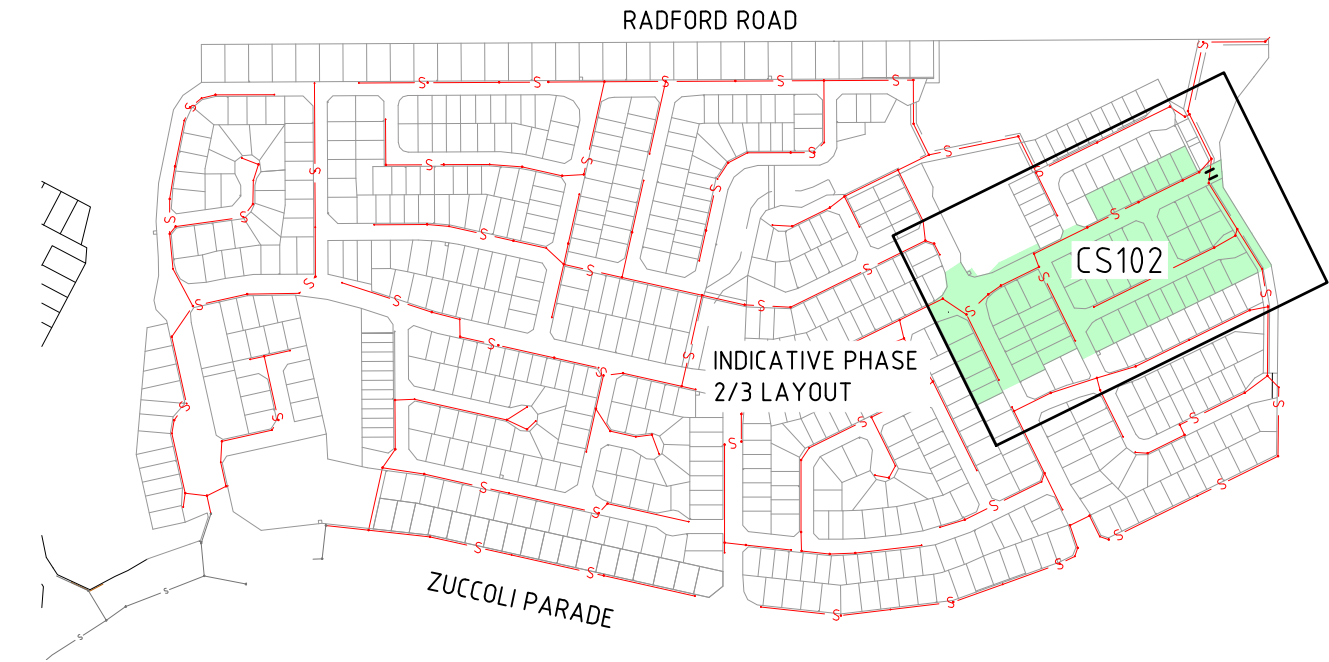

**MANHOLE DETAILS U.N.O.**  
REFER LONGITUDINAL SECTIONS

C: CIRCULAR MANHOLE  
R: RECTANGULAR LID  
D: CLASS D TRAFFICABLE LID

**WARNING**  
**BWARE OF SERVICES**

THE LOCATIONS OF ALL EXISTING SERVICES ARE APPROXIMATE ONLY AND THEIR EXACT POSITION SHOULD BE PROVEN ON SITE BY CONTRACTOR. NO GUARANTEE IS GIVEN THAT ALL EXISTING SERVICES ARE SHOWN.


**On behalf of WATER SERVICES, for incorporation into POWER WATER CORP'S network.**

THIS DRAWING IS APPROVED FOR THE CONSTRUCTION OF ALL WATER & SEWER COMPONENTS AS SHOWN ON THE DRAWINGS

This approval does not relieve the developer and consultant from full responsibility for the correctness of the design and associated documents

This drawing is valid only for 2 years from date of signing


SIGNED \_\_\_\_\_ DATE \_\_\_\_\_

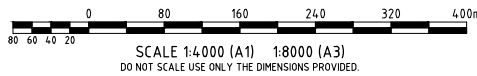

**SEWERAGE RETICULATION LOCALITY PLAN**  
SCALE 1:4000

**AS CONSTRUCTED INFORMATION CERTIFIED BY BMD URBAN PTY LTD**

SIGNED: \_\_\_\_\_ DATED: 03/07/2018

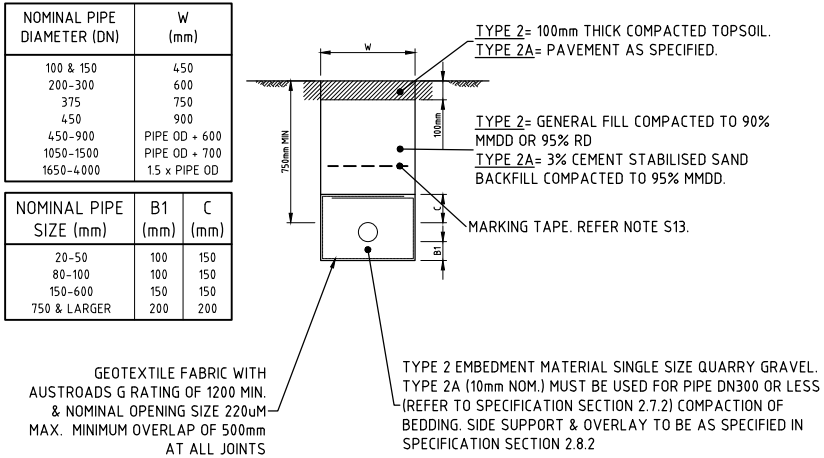

**TYPE 2/2A TRENCH DETAIL**  
SCALE 1:20

**POWER AND WATER STANDARD NOTES**

**GENERAL**

- WS.1.** CONSTRUCTION OF THE WATER AND SEWERAGE WORKS ARE CARRIED OUT IN ACCORDANCE WITH THE LATEST AMENDMENT OF THE APPROVED PROJECT DRAWINGS AND SPECIFICATION, AS SIGNED BY A SERVICES DEVELOPMENT OFFICER, AND THE POWER AND WATER CONNECTION CODE POWER AND WATER MASTER SPECIFICATION AND ASSOCIATED DOCUMENTS.
- WS.2.** CONSTRUCTION SITE DESIGN DRAWINGS MUST BE SIGNED AS 'APPROVED FOR CONSTRUCTION' BY A POWER AND WATER SERVICES DEVELOPMENT OFFICER.
- WS.3.** PRIOR TO COMMENCEMENT OF WORKS THE CONSTRUCTOR SHALL CHECK THE LOCATION OF ALL UNDERGROUND SERVICES, AND CONFIRM FINISHED SURFACE LEVELS AND CHECK THE MATERIAL, DIAMETER, ALIGNMENT, LEVEL AND LOCATION OF EXISTING PIPEWORK AT THE CONNECTION POINT. IT IS NOT GUARANTEED THAT ALL SERVICES HAVE BEEN SHOWN ON THE DRAWINGS.
- WS.4.** CHANGES REQUESTED BY ANY PARTY TO THE DESIGN OF THE WORKS DURING ANY STAGE OF THE DEVELOPMENT MUST BE ENDORSED BY THE CERTIFYING HYDRAULIC CONSULTING ENGINEER/DESIGNER WITH AMENDED DRAWINGS SUBMITTED TO POWER AND WATER FOR APPROVAL PRIOR TO THE CHANGE BEING CARRIED OUT.
- WS.5.** SEVEN (7) DAYS WRITTEN NOTICE MUST BE GIVEN TO SERVICES DEVELOPMENT, POWER AND WATER, WITH A 'NOTICE OF INTENTION TO START WORK' PRIOR TO COMMENCEMENT OF WORK (FORM AVAILABLE ON THE CONNECTION CODE WEBSITE).
- WS.6.** THE CONTRACTOR SHOULD CONFIRM WITH SERVICES DEVELOPMENT IF A MEETING IS REQUIRED WITH POWER AND WATER, THE HYDRAULIC CERTIFIER AND THE DEVELOPER PRIOR TO COMMENCEMENT OF SITE WORKS.
- WS.7.** EXISTING SERVICE CONNECTIONS TO REMAIN IN SERVICE UNTIL THE CONSTRUCTION OF THE NEW SERVICE IS COMPLETED TO THE SATISFACTION OF POWER AND WATER.
- WS.8.** ALL LEVELS GIVEN ARE TO AUSTRALIAN HEIGHT DATUM (AHD) IN METRES TO THREE DECIMAL PLACES. PROJECTION ARE BASED ON MGA94 MAP GRID OF AUSTRALIA ZONE 52 OR 53 COORDINATE SYSTEM.
- WS.9.** ALL DIMENSIONS ARE IN MILLIMETRES AND ALL CHAINAGES AND LEVELS LEVEL IN METRES UNLESS SHOWN OTHERWISE.
- WS.10.** MINIMUM COVER TO PIPE IS 750MM IN TRAFFICABLE AREAS, 600mm IN OTHER AREAS. 1500mm COVER REQUIRED FOR THRUST BORING UNDER ROAD.
- WS.11.** MINIMUM CLEARANCES BETWEEN UNDERGROUND SERVICES IS AS PER WSA 02-2003 TABLE 4.2 FOR SEWER, AND WSA 03-2003 TABLE 4.1 FOR WATER. A MINIMUM VERTICAL CLEARANCE OF 300mm FOR ALL SERVICE CROSSINGS IS TO BE MAINTAINED.

**EXCAVATION AND FILLING**

- WS.12.** OBTAIN PERMIT/S FROM THE RELEVANT ROAD AUTHORITY OR COUNCIL PRIOR TO ANY EXCAVATION WITHIN THE ROAD RESERVE. THE CONTRACTOR/DEVELOPER IS REQUIRED TO SEEK A WRITTEN APPROVAL FORM THE LAND OWNER OF THE EXISTING EASEMENT TO ACCESS AND EXCAVATE WITHIN THEIR PROPERTY. THE CONTRACTOR/DEVELOPER IS REQUIRED TO SUPPLY THAT WRITTEN APPROVAL TO POWER AND WATER SEVEN (7) DAYS PRIOR TO THE START OF CONSTRUCTION WORKS.
- WS.13.** BACKFILLING MATERIAL, OUTSIDE ROAD PAVEMENT OR DRAIN, MUST COMPLY WITH THE POWER AND WATER MASTER SPECIFICATION REQUIREMENTS FOR GENERAL BACKFILL. USE TYPE 2 EMBEDMENT WRAPPED WITH GEOTEXTILE WITH SELECTED BACKFILL OR 3% CEMENT STABILISED SAND BACKFILL FOR ALL ROAD CROSSINGS. USE 5% CEMENT STABILISED GRAVEL BACKFILL BENEATH ALL OUD CROSSING.
- WS.14.** PROVIDE A MINIMUM OF TYPE 2 EMBEDMENT FOR PVC PIPE OR TYPE 4 EMBEDMENT FOR STEEL PIPE UNLESS GEOTECHNICAL INVESTIGATIONS HAVE BEEN COMPLETED AND THE CONSULTANT REPORT SUPPORTS THE USE OF LOWER QUALITY EMBEDMENT. ANY CHANGE TO THE PROPOSED BEDDING TYPE MUST BE APPROVED BY POWER AND WATER.
- WS.15.** WHEN EMBEDMENT TYPE CHANGES, A VERTICAL GEOTEXTILE BARRIER ARE INSERTED BETWEEN THE EMBEDMENT TYPES.
- WS.16.** REINSTATE ALL SURFACES UPON COMPLETION OF THE WORKS AS SPECIFIED OR AS GOOD AS EXISTING TO THE SATISFACTION OF THE RELEVANT AUTHORITY.

**COMMISSIONING**

- WS.17.** SIGNED HARD COPY (A3 SIZE - REQUIRED FOR ALL SUBDIVISIONS) AND ELECTRONIC FORMAT (BOTH x.PDF AND CAD x.DGN/x.DWG) 'AS-CONSTRUCTED' DRAWINGS, OTHER INSTALLATION DOCUMENTATION, AND APPROPRIATE RECORDS OF CONSTRUCTION PROGRESS (PHOTOS) MUST BE PROVIDED TO SERVICES DEVELOPMENT, POWER AND WATER PRIOR TO HANDOVER INSPECTION. ENSURE ALL AS-CONSTRUCTED INFORMATION HAS BEEN PICKED UP BY THE SURVEYOR PRIOR TO BACKFILLING.
- WS.18.** 'AS-CONSTRUCTED' DRAWINGS TO BE CERTIFIED BY THE CERTIFYING ENGINEER. 'AS-CONSTRUCTED' SURVEY BY A REGISTERED SURVEYOR.
- WS.19.** DESIGNER TO CONTACT SERVICES DEVELOPMENT, POWER AND WATER, TO ARRANGE FOR HANDOVER INSPECTIONS. SEVEN (7) DAYS NOTICE MUST BE PROVIDED PRIOR TO HANDOVER INSPECTIONS.
- WS.20.** THE CONSTRUCTOR IS RESPONSIBLE FOR ALL CONNECTION FEES, ALL EXCAVATION, SHORING IF REQUIRED, BACKFILLING, REINSTATEMENT OF AREA, SUPPLY OF DIGGING AND LIFTING MACHINERY WHERE REQUIRED, PERMITS, TRAFFIC CONTROL, SUPPLY OF ALL MATERIALS, PIPES AND FITTINGS.
- WS.21.** POWER AND WATER PERSONNEL SHALL INSTALL ALL NEW WATER CONNECTIONS TO EXISTING MAINS. ENSURE REQUIRED WATER CONNECTION FITTINGS ARE BOLTED TOGETHER AND READY TO BE INSTALLED UPON SHUTDOWN. THE WATER CONNECTION ARE COMPLETED PRIOR TO THE CONSTRUCTION OF THE NEW WATER SERVICE. THIS IS ONLY ALLOWED IF A VALVE LOCK IS INSTALLED BY POWER AND WATER CORPORATION ON THE SLUICE VALVE TO THE WATER MAIN. PRESSURE TESTING AGAINST THE SLUICE VALVE IS PERMITTED TO A MINIMUM OF 1000KPA AND A MAXIMUM PRESSURE OF 1200KPA UNLESS PREVIOUSLY SPECIFIED. IF THE CONSTRUCTOR SUSPECTS THE SLUICE VALVE IS LEAKING UNDER PRESSURE TESTING THEN CONTACT THE SUPPLIER FOR REPLACEMENT. THE VALVE LOCK WILL BE REMOVED BY POWER AND WATER AFTER THE HANDOVER OF THE ASSET HAS BEEN ACHIEVED.
- WS.22.** POWER AND WATER PERSONNEL SHALL INSTALL ALL NEW SEWER CONNECTIONS TO EXISTING MAINS. A PHYSICAL ISOLATION MUST BE IN PLACE BETWEEN THE EXISTING LIVE SEWER AND THE PROPOSED GIFTED ASSET. THE PHYSICAL ISOLATION DEVICE WILL BE REMOVED BY POWER AND WATER AFTER THE HANDOVER OF THE ASSET HAS BEEN ACHIEVED.
- WS.23.** AT NO STAGE SHALL ANY CONTRACTOR CARRY OUT WORK ON POWER AND WATER INFRASTRUCTURE.
- ACCEPTANCE AND DEFECTS LIABILITY PERIOD**
- WS.24.** AT LEAST SEVEN (7) WORKING DAYS NOTICE MUST BE PROVIDED TO SERVICES DEVELOPMENT, POWER AND WATER FOR APPLICATION OF A CERTIFICATE OF FINAL COMPLIANCE/DEVELOPMENT PERMIT CLEARANCE ALLOWING FOR AN INSPECTION AND REPORT OF OUTSTANDING DEFECTS/ISSUES. UPON NOTICE TO SERVICES DEVELOPMENT THAT RECTIFICATION OF OUTSTANDING DEFECTS/ISSUES HAS BEEN ADDRESSED, AN ADDITIONAL SEVEN (7) WORKING DAYS SHOULD BE ALLOWED FOR.
- WS.25.** A TWENTY-FOUR (24) MONTH DEFECTS LIABILITY PERIOD FOR EXTENSIONS AND SUBDIVISIONS, AND A TWELVE (12) MONTH DEFECTS LIABILITY PERIOD FOR BUILDING DEVELOPMENTS, WILL COMMENCE ONCE THE CERTIFICATE OF FINAL COMPLIANCE/DEVELOPMENT PERMIT CLEARANCE HAS BEEN ISSUED. ALL DEFECT LIABILITIES IDENTIFIED WITHIN THIS PERIOD IS THE RESPONSIBILITY OF THE DEVELOPER. ANY WORKS SUBJECT TO A DEFECT DURING THE DEFECT PERIOD THAT REQUIRES POWER AND WATER TO UNDERTAKE AN EMERGENCY REPAIR, ARE SUBJECT TO AN EXTENDED DEFECT PERIOD OF 5 YEARS.

**POWER AND WATER (SEWER NOTES)**

- S.1.** ALL GRAVITY SEWER PIPES ARE UPVC DWV CLASS SN8 WITH STYRENE-BUTADIENE RUBBER RING JOINTS (SBR), UNLESS NOTED OTHERWISE.
- S.2.** SEWERS ARE OFFSET FROM PROPERTY BOUNDARIES A DISTANCE OF 1.6m IN ROAD RESERVES AND 1.5m IN PRIVATE PROPERTY, EXCEPT WHERE SHOWN OTHERWISE ON THE DRAWINGS.
- S.3.** FOR SEWER SHOW POSITION (MGA AND LEVELS TO AHD) OF ALL MAINTENANCE HOLES, MAINTENANCE SHAFTS, INSPECTION OPENINGS, SEPARATION DISTANCES/LEVELS TO CROSSING SERVICES, ALL OTHER VALUES REQUIRED TO CERTIFY COMPLIANCE OF THE DRAWINGS.
- S.4.** ALL GRAVITY SEWERS ARE TO BE A MINIMUM OF DN150, UNLESS NOTED OTHERWISE.
- S.5.** MAINTENANCE HOLE/SHAFT COVERS AND SLABS SHALL FINISH AT: FINISHED SURFACE LEVEL IN ROAD RESERVES AND FOOTPATHS AND MATCH CROSS FALL AWAY FROM MAINTENANCE HOLES, 150mm ABOVE SURFACE LEVEL IN PRIVATE PROPERTY AND OPEN SPACE (BACKFILL TO BE GRADED AT 1 IN 10 FROM MAINTENANCE HOLES TO FINISHED SURFACE LEVEL).
- S.6.** THE CONSTRUCTOR SHALL EITHER INSCRIBE OR ATTACH A PLATE TO THE MAINTENANCE HOLE OR MAINTENANCE SHAFT COVER WITH THE IDENTIFYING NUMBER AS SHOWN ON THE DRAWINGS.
- S.7.** FLEXIBLE JOINTS WITH CONCRETE SURROUND ARE CONSTRUCTED ON BOTH UPSTREAM AND DOWNSTREAM SIDES OF THE MAINTENANCE HOLES.
- S.8.** DEPTH TO INVERT AT MAINTENANCE HOLES IS CALCULATED FROM THE TOP OF MAINTENANCE HOLES.
- S.9.** MINIMUM CONCRETE STRENGTH FOR ALL SEWERAGE STRUCTURES INCLUDING MAINTENANCE HOLES SHALL BE N50. USE GP CEMENT WITH SILICA FUME CONTENT AS SPECIFIED.
- S.10.** ALIGN MAINTENANCE HOLE COVER SUCH THAT THE LONG SIDE OF THE LID IS PARALLEL WITH THE SEWER MAIN.
- S.11.** ALL SEWER RISING MAINS SHALL BE PVC-0 CLASS 16 RRJ, UNLESS NOTED OTHERWISE.
- S.12.** USE DIFBL SO-SO CONNECTORS (OF MAXIMUM 2 DEGREE DEFLECTION) OR DIFBL BENDS FOR SEWER RISING MAINS, UNLESS NOTED OTHERWISE.
- S.13.** MARKING TAPE COLOURED ORANGE AND MARKED 'SEWER MAIN' ARE LAID CONTINUOUSLY AND LOCATED 300MM ABOVE THE SEWER PIPEWORK.
- S.14.1.** LIVE CONNECTIONS TO EXISTING SEWER MAINS WILL ONLY BE CARRIED OUT WHEN ALL WORKS AND TESTING (HYDROSTATIC AND CCTV) ARE COMPLETE IN ACCORDANCE WITH THE APPROVED DESIGN DRAWINGS AND PROCEDURES, AND HAVE SATISFACTORILY PASSED FINAL HANDOVER INSPECTION.

**ADDITIONAL SEWER NOTES**

- S.101.** THE SUPERINTENDENT IN CONSULTATION WITH GEOTECHNICAL PERSONNEL SHALL DETERMINE WATER PIPE BEDDING TYPE AFTER INSPECTION OF THE EXCAVATED TRENCH. TYPE 2A BEDDING AND GEOTEXTILE FABRIC ARE USED UNDER ROADS AND AT OTHER LOCATIONS AS SHOWN ON THE DRAWINGS. ALL ROAD CROSSINGS ARE BACKFILLED TO A STRINGENT COMPACTION STANDARD, USING A NATURAL GRAVEL FOR THE FULL WIDTH OF THE TRENCH TO SUBGRADE LEVEL.
- S.102.** ALL SEWER MAINS ARE SUBJECT TO CCTV INSPECTION IN ACCORDANCE WITH PWC CONNECTION CODE.
- S.103.** UNDERTAKE 2 DISTORTION TESTS OF MAINS, ONE 3 MONTHS AFTER COMPLETION AND THE SECOND AFTER THE FIRST WET SEASON.
- S.104.** PROVIDE CEMENT STABILISED BACKFILL UNDER DRAINAGE PATHS OR OPEN DRAINS.
- S.105.** THE DISTANCE TO DOWNSTREAM MANHOLE IS THE PERPENDICULAR DISTANCE TO THE MAIN FROM THE LOT CONNECTION.
- S.106.** THE DISTANCE TO DOWNSTREAM MANHOLE IS THE PERPENDICULAR DISTANCE TO THE MAIN FROM THE LOT CONNECTION.
- S.107.** TRENCHSTOPS OR BULKHEADS TO BE CONSTRUCTED IN ACCORDANCE WITH WSAA STANDARD DRAWING WAT-1209 WHERE WATERMAIN GRADE EXCEEDS 5%.

POWER WATER CORPORATION - SEWER	
W2-1-01/7	TYPE 1 SEWER CONNECTION DN 100 AND DN 150
W2-1-02/6	TYPE 2 SEWER CONNECTION DN 100 AND DN 150
W2-1-04/6	SEWER CONNECTION LAYOUTS DN 100 AND DN 150
W2-1-05/5	INTERMEDIATE AND TERMINAL INSPECTION OPENINGS LIGHT AND HEAVY DUTY ARRANGEMENTS
W2-1-06/1	TERMINAL MAINTENANCE SHAFT AND PROPERTY CONNECTION DETAIL
W2-1-07/1	SANITARY PLUMBING AND DRAINAGE INFORMATION DRAWING ONLY
W2-1-08/5	TYPE 4 AND 5 SEWER CONNECTIONS DN100 AND DN 150
W2-2-01A/1	ACCESS CHAMBERS CAST INSITU CIRCULAR CHAMBERS (UP TO 6.0m DEEP) SHEET 1 OF 4
W2-2-01D/1	ACCESS CHAMBERS CAST INSITU AND PRECAST NOTES FOR CONSTRUCTION SHEET 4 OF 4
W2-2-02/4	ACCESS CHAMBERS PRECAST CHAMBERS (UP TO 6.0m DEEP)
W2-2-03/4	ACCESS CHAMBERS EXTERNAL AND INTERNAL DROPS TYPES 1-4
W2-1-10/1	TYPE 5 SEWER CONNECTION
W2-2-07/3	MAINTENANCE SHAFT TYPICAL ARRANGEMENT
W2-2-08/1	MAINTENANCE SHAFT PIPELINE CONNECTION DETAILS


CONTRACTOR TO CONFIRM THAT THE LATEST REVISIONS ARE USED FOR CONSTRUCTION

POWER WATER CORP. DRG No. B17-9034

No.	Amendments	Drawn	Design	Appd	Registered Engineer	Reg No.	Date
1	AS CONSTRUCTED	MC	LW	WS			21/06/18
0	FOR CONSTRUCTION	MC	LW	WS			22/01/18

This drawing cannot be copied or reproduced in any form or used for any purpose other than that originally intended without the written permission of Empower Engineers and Project Managers ©COPYRIGHT 2018



Client	URBEX AND LAND DEVELOPMENT CORP. (JV)	Datum AHD PSM RL (MGA) COORD	
Project	ZUCCOLI PHASE 3.3		
Title	SEWERAGE RETICULATION LOCALITY PLAN AND NOTES	AS CONSTRUCTED	
Project No.		Drawing No.	Rev
B00176-CS001			1

# LEGEND

- LAYBACK KERB AND CHANNEL FACE
- UPRIGHT KERB FACE
- AS CONSTRUCTED SEWERAGE RETICULATION
- AC AS CONSTRUCTED ACCESS CHAMBER
- MS AS CONSTRUCTED MAINTENANCE SHAFT
- TMS AS CONSTRUCTED TERMINAL MAINTENANCE SHAFT
- PHASE BOUNDARIES

On behalf of WATER SERVICES, for incorporation into POWER WATER CORP'S network.

THIS DRAWING IS APPROVED FOR THE CONSTRUCTION OF ALL WATER & SEWER COMPONENTS AS SHOWN ON THE DRAWINGS

This approval does not relieve the developer and consultant from full responsibility for the correctness of the design and associated documents

This drawing is valid only for 2 years from date of signing

SIGNED \_\_\_\_\_ DATE \_\_\_\_\_

## WARNING

### BEWARE OF SERVICES

THE LOCATIONS OF ALL EXISTING SERVICES ARE APPROXIMATE ONLY AND THEIR EXACT POSITION SHOULD BE PROVEN ON SITE BY CONTRACTOR. NO GUARANTEE IS GIVEN THAT ALL EXISTING SERVICES ARE SHOWN.

AS CONSTRUCTED  
INFORMATION CERTIFIED BY  
BMD URBAN PTY LTD


SIGNED: \_\_\_\_\_ DATED: 03/07/2018

### LIVE CONNECTION

LIVE CONNECTION BY POWERWATER CORP. AT DEVELOPER EXPENSE. CONNECT TO STUB FROM AC 3/A1. PLUG TO BE INSTALLED UPSTREAM AND DOWNSTREAM PIPES PRIOR TO COMMENCEMENT OF WORKS TO ISOLATE FROM LIVE SEWER. CONTRACTOR TO UNDERTAKE REGULAR CHECKS TO ENSURE PLUG REMAINS IN PLACE

### LIVE CONNECTION

LIVE CONNECTION BY POWERWATER CORP. AT DEVELOPER EXPENSE. CONNECT TO STUB FROM AC 5/A1. PLUG TO BE INSTALLED UPSTREAM AND DOWNSTREAM PIPES PRIOR TO COMMENCEMENT OF WORKS TO ISOLATE FROM LIVE SEWER. CONTRACTOR TO UNDERTAKE REGULAR CHECKS TO ENSURE PLUG REMAINS IN PLACE

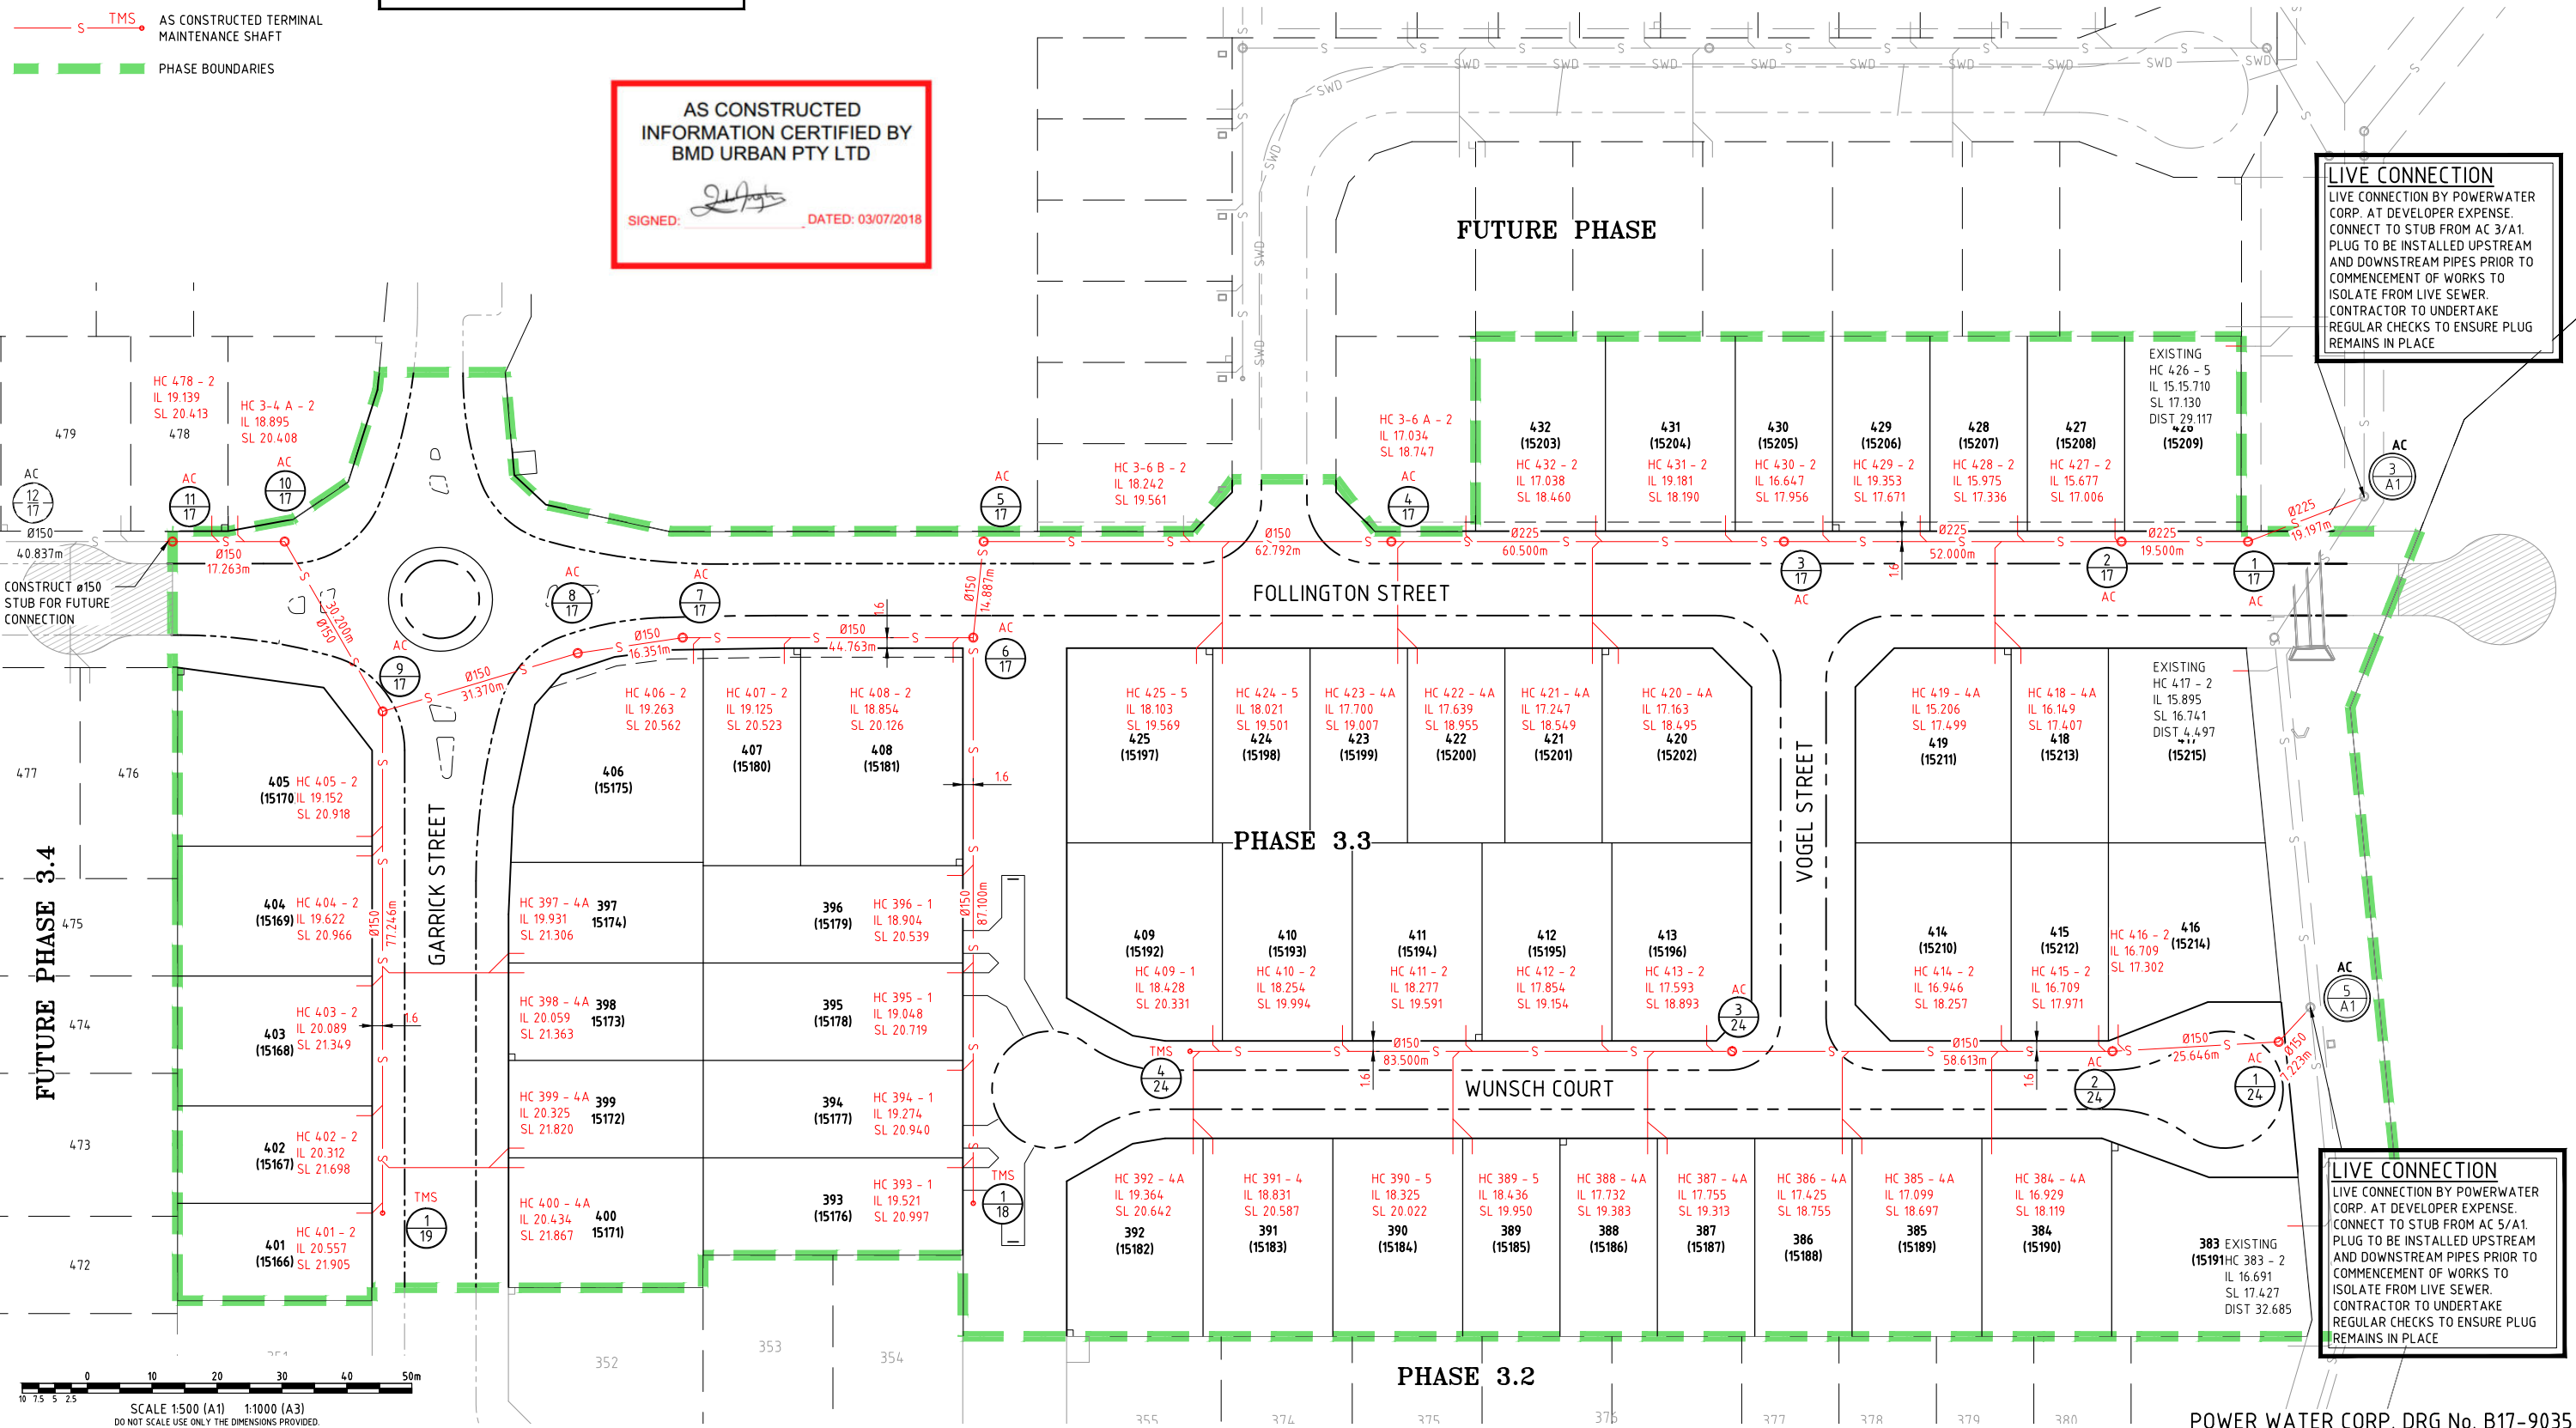


POWER WATER CORP. DRG No. B17-9035


No.	Amendments	Drawn	Design	Appd	Registered Engineer	Reg No.	Date
1	AS CONSTRUCTED	MC	LW	WS			21/06/18
0	FOR CONSTRUCTION	MC	LW	WS			22/01/18

This drawing cannot be copied or reproduced in any form or used for any purpose other than that originally intended without the written permission of Empower Engineers and Project Managers ©COPYRIGHT 2018




Client	URBEX AND LAND DEVELOPMENT CORP. (JV)	Datum	AHD
Project	ZUCCOLI PHASE 3.3	PSM	RL
Title	SEWERAGE RETICULATION LAYOUT PLAN	(MGA) COORD	
Project No.	B00176-CS002	Drawing No.	1

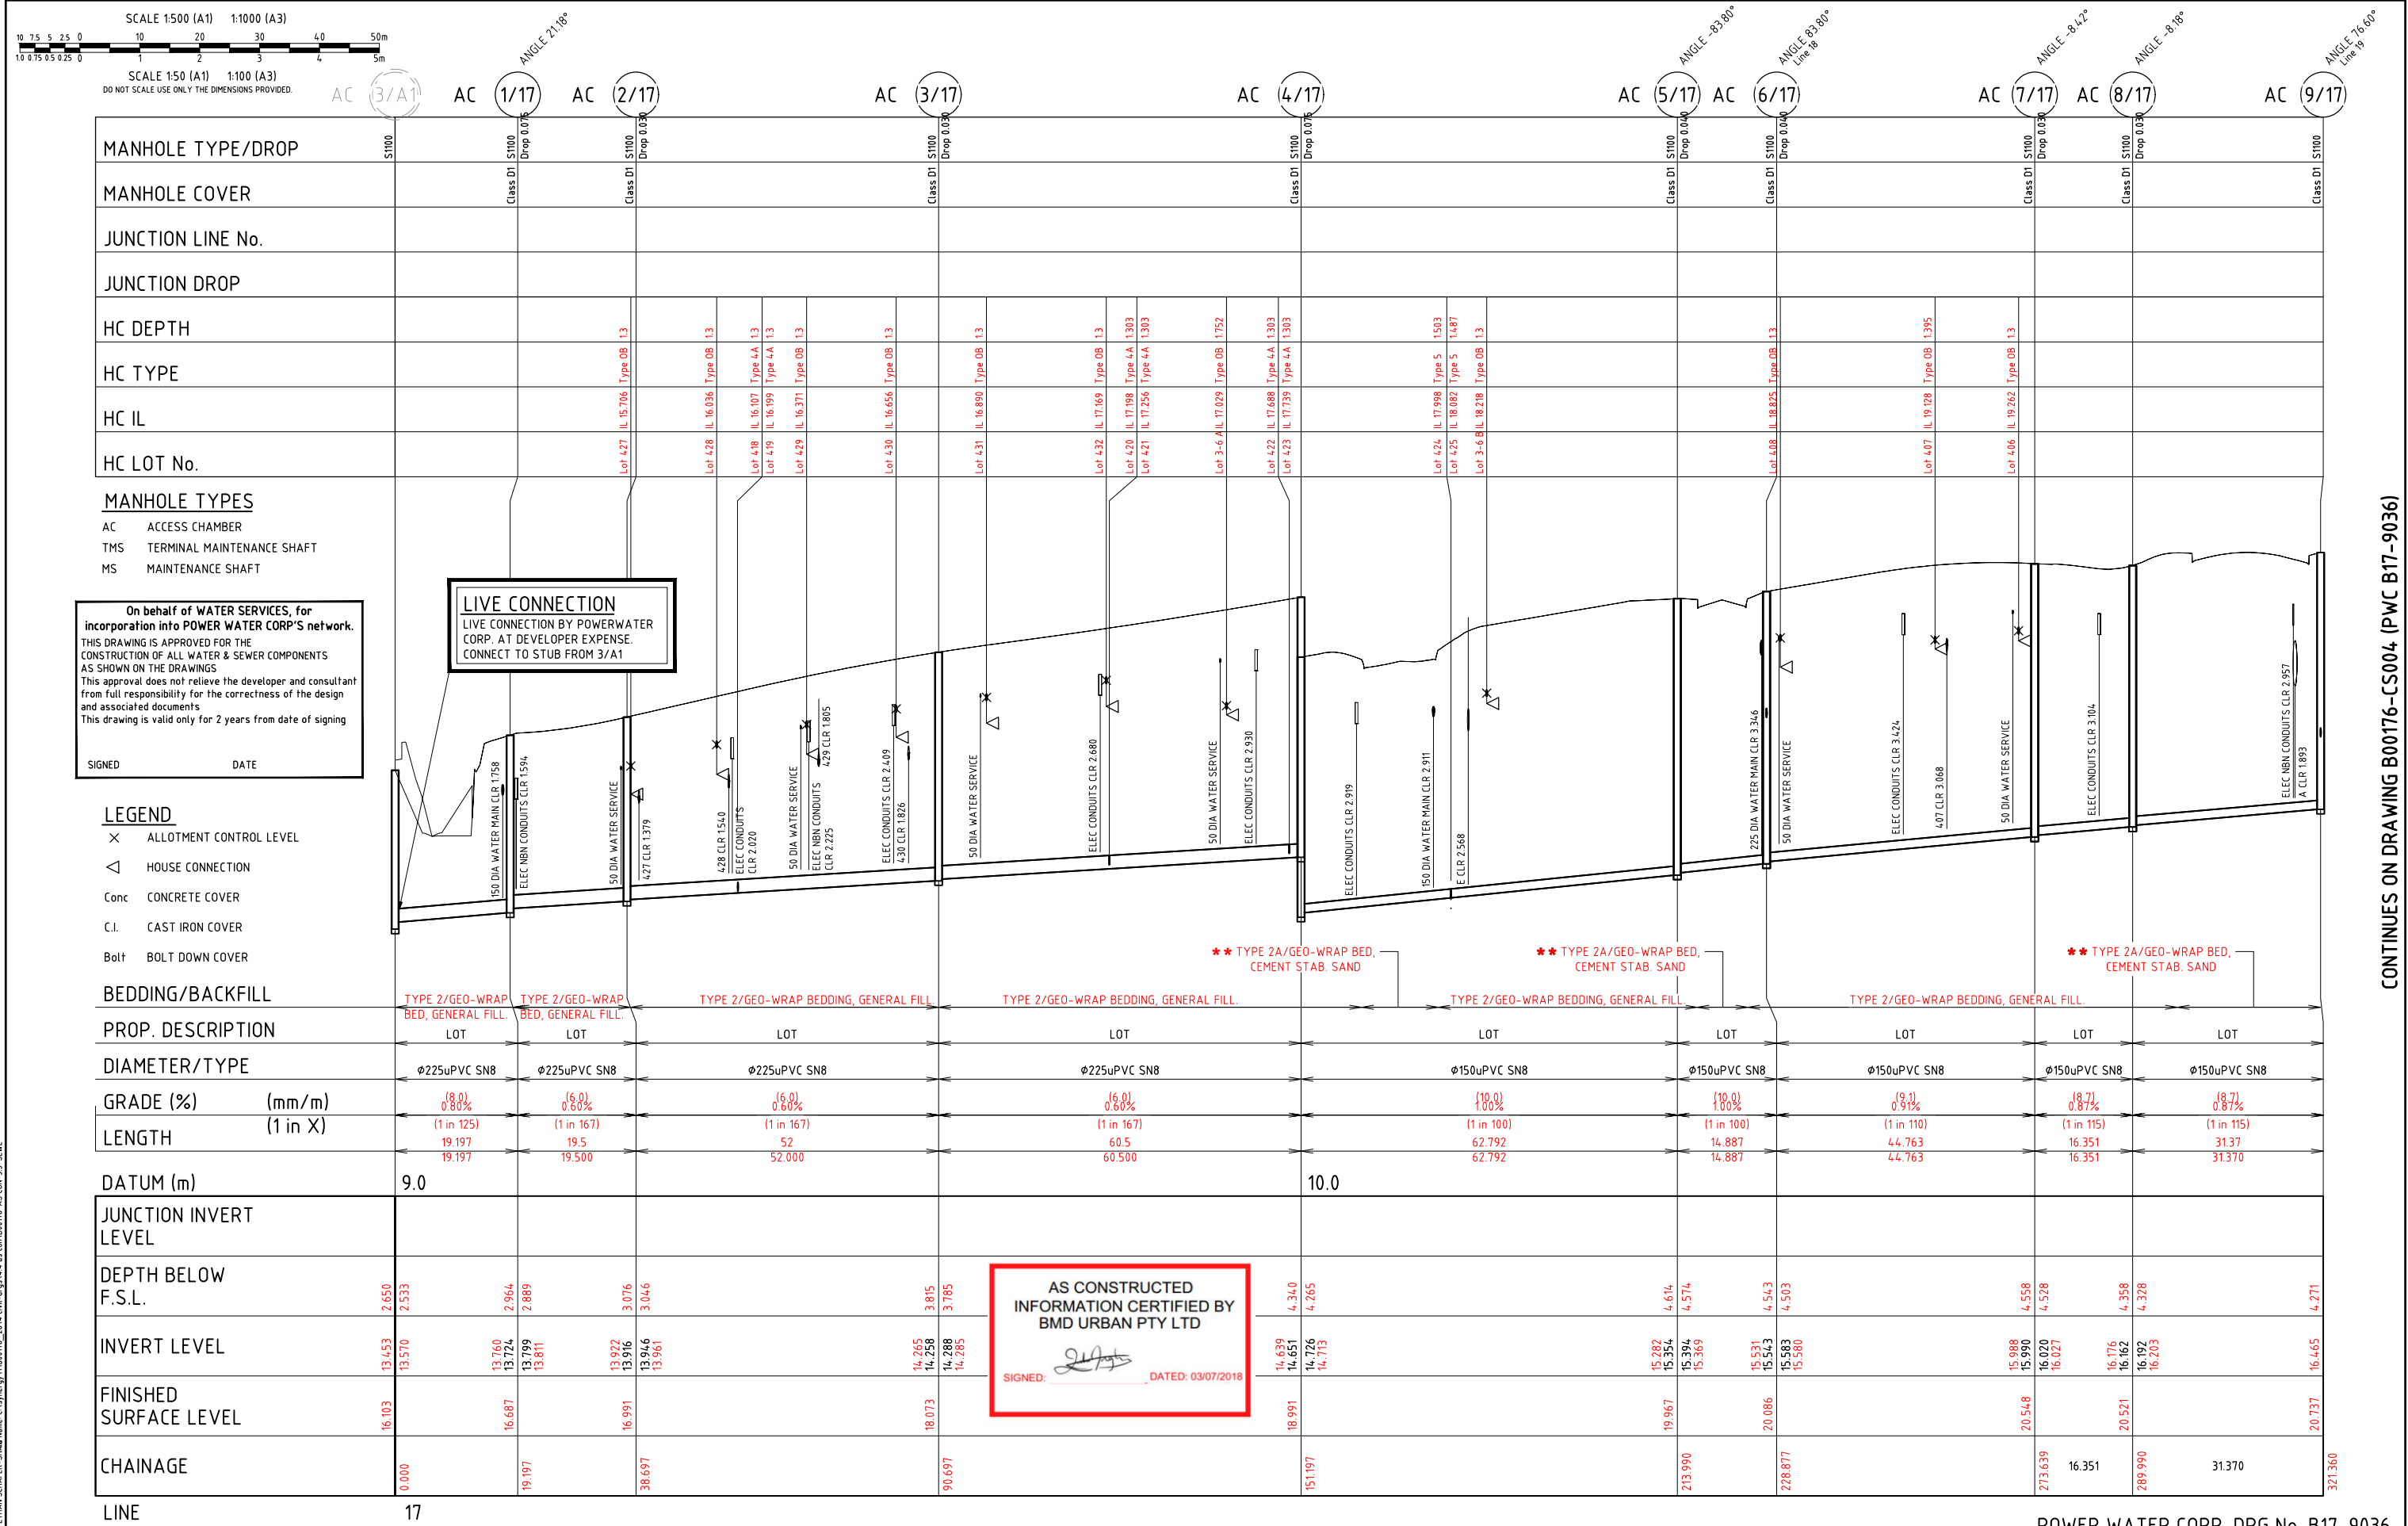

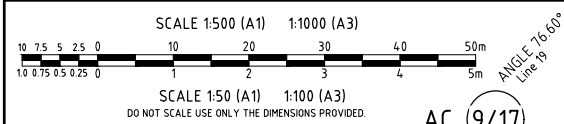

MANHOLE TYPE/DROP	AC 9/17	AC 10/17	AC 11/17	AC 12/17
MANHOLE COVER	Class D1	Class D1	Class D1	Class D1
JUNCTION LINE No.				
JUNCTION DROP				
HC DEPTH				
HC TYPE				
HC IL				
HC LOT No.				
MANHOLE TYPES	AC ACCESS CHAMBER TMS TERMINAL MAINTENANCE SHAFT MS MAINTENANCE SHAFT			
PROP. DESCRIPTION	CONTINUES ON DRAWING B00176-CS003 (PWC B17-9036)			
DIAMETER/TYPE	LOT			
GRADE (%)	LOT			
LENGTH	LOT			
DATUM (m)	12.0			
JUNCTION INVERT LEVEL				
DEPTH BELOW F.S.L.				
INVERT LEVEL				
FINISHED SURFACE LEVEL				
CHAINAGE				

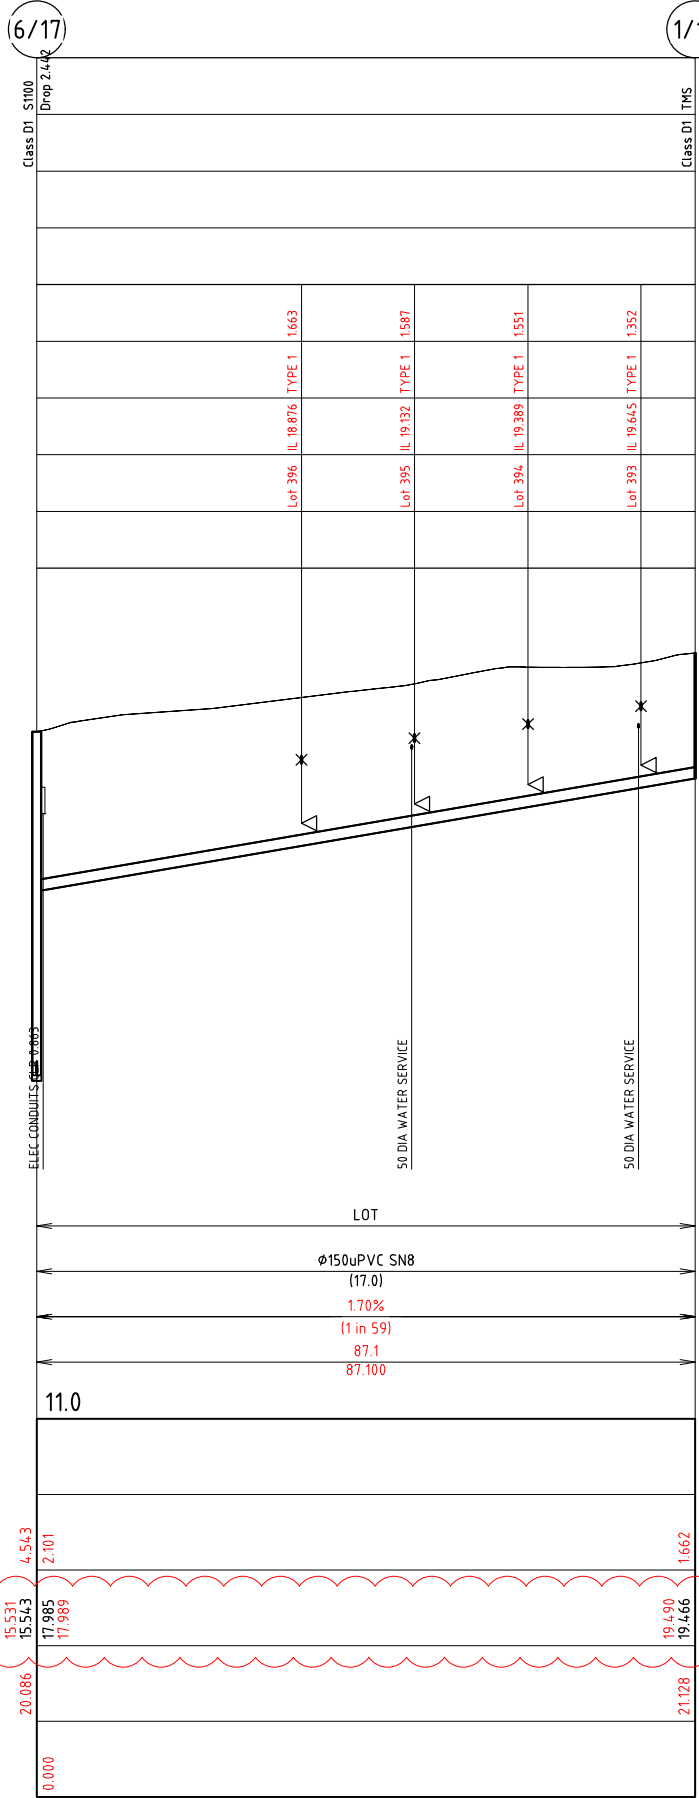

AS CONSTRUCTED  
INFORMATION CERTIFIED BY  
BMD URBAN PTY LTD

SIGNED:  DATED: 03/07/2018

User: ETHAN SCHAEFER-SRW\Name: C:\pwworkspace\B00176\_2014\civil-draws\4.4.as con\B00176-AS CON-3.3-SEWL  
Plot Date: 4/07/2018 2:55:42 PM

No.	Amendments	Drawn	Design	Appd	Registered Engineer	Reg No.	Date
1	AS CONSTRUCTED	MC	LW	WS			21/06/18
0	FOR CONSTRUCTION	MC	LW	WS			22/01/18



Client	URBEX AND LAND DEVELOPMENT CORP. (JV)	Datum	AHD
Project	ZUCCOLI PHASE 3.3	PSM	RL
Title	SEWERAGE RETICULATION LONGITUDINAL SECTION SHEET 2 OF 3	(MGA) COORD	
Project No.	B00176-CS004	Drawing No.	1

MANHOLE TYPE/DROP	Class D1	S100	Drop 0.03	Type 11
MANHOLE COVER				
JUNCTION LINE No.				
JUNCTION DROP				
HC DEPTH				
HC TYPE				
HC IL				
HC LOT No.				

## MANHOLE TYPES

AC	ACCESS CHAMBER
TMS	TERMINAL MAINTENANCE SHAFT
MS	MAINTENANCE SHAFT

**LIVE CONNECTION**  
LIVE CONNECTION BY POWERWATER  
CORP. AT DEVELOPER EXPENSE.  
CONNECT TO STUB FROM 5/A1

**On behalf of WATER SERVICES, for  
incorporation into POWER WATER CORP'S network.**  
THIS DRAWING IS APPROVED FOR THE  
CONSTRUCTION OF ALL WATER & SEWER COMPONENTS  
AS SHOWN ON THE DRAWINGS  
This approval does not relieve the developer and consultant  
from full responsibility for the correctness of the design  
and associated documents  
This drawing is valid only for 2 years from date of signing

SIGNED	DATE
--------	------

LEGEND

- |      |                         |
|------|-------------------------|
| X    | ALLOTMENT CONTROL LEVEL |
| ◁    | HOUSE CONNECTION        |
| Conc | CONCRETE COVER          |
| C.I. | CAST IRON COVER         |
| Bolt | BOLT DOWN COVER         |

## BEDDING/BACKFILL

PROP. DESCRIPTION	LOT	LOT	LOT	LOT
DIAMETER/TYPE	Ø150uPVC SN8	Ø150uPVC SN8	Ø150uPVC SN8	Ø150uPVC SN8
GRADE (%) (mm/m)	(24.0) 2.40%	(14.9) 1.49%	(24.0) 2.40%	(19.0) 1.90%
LENGTH (1 in X)	(1 in 42) 25.646 25.646	(1 in 67) 58.613 58.613	(1 in 42) 83.5 83.500	(1 in 53) 7.223 7.223
DATUM (m)	10.0			9.0
JUNCTION INVERT LEVEL				
DEPTH BELOW F.S.L.	2.540 2.510	2.410 2.380	2.408 2.320	2.640 2.504 2.540
INVERT LEVEL	14.896 14.892 14.911	15.541 15.538 15.568 15.562	16.442 16.439 16.527	18.538 18.531
FINISHED SURFACE LEVEL	17.432 17.432	17.948 17.948	18.847 18.847	20.398 20.398
CHAINAGE	7.223	32.869	91.482	114.982

LINE

24

24


**On behalf of WATER SERVICES, for  
incorporation into POWER WATER CORP'S network.**

THIS DRAWING IS APPROVED FOR THE  
CONSTRUCTION OF ALL WATER & SEWER COMPONENTS  
AS SHOWN ON THE DRAWINGS

This approval does not relieve the developer and consultant  
from full responsibility for the correctness of the design  
and associated documents

This drawing is valid only for 2 years from date of signing

SIGNED	DATE
--------	------

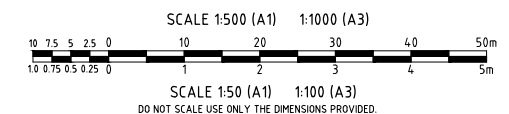

POWER WATER CORP. DRG No. B17-9038



LAND DEVELOPMENT CORPORATION


urbex












**Empower**  
ENGINEERS &  
PROJECT MANAGERS

<i>Client</i>	<b>URBEX AND LAND DEVELOPMENT CORP. (JV)</b>	<i>Date</i> <b>AHD</b>	
<i>Project</i>	<b>ZUCCOLI PHASE 3.3</b>	<b>PSM</b>	
<i>Title</i>	<b>SEWERAGE RETICUALTION LONGITUDINAL SECTION SHEET 3 OF 3</b>	<b>RL (MGA) COORD</b>	<b>AS CONSTRUCTED</b>
		<i>Project No.</i> <b>B00176-CS005</b>	<i>Drawing No.</i> <b>1</b>

Plot Date: 4/07/2018 2:55:44 PM User: ETHAN SCHAEER-SRWName: C:\synergy\1\000176\_2014\_civil-draws\4.4.as con\B00176-AS CON-3.3-SEW

AS CONSTRUCTED  
INFORMATION CERTIFIED BY  
BMD URBAN PTY LTD

SIGNED:  DATED: 03/07/2018

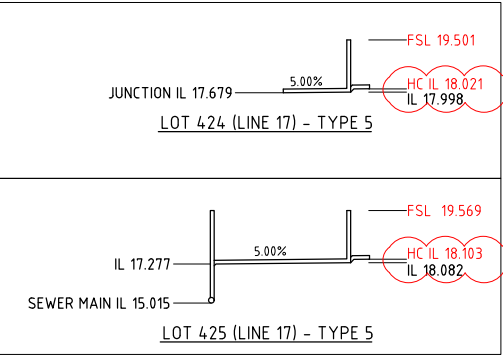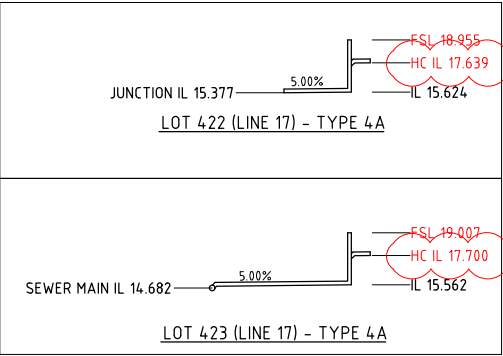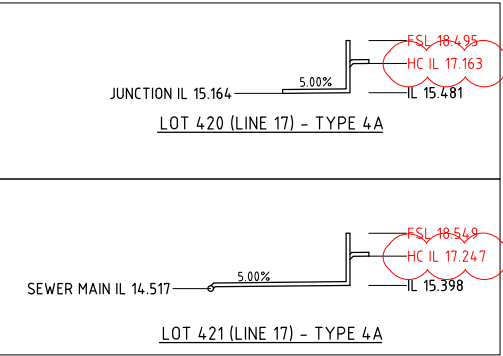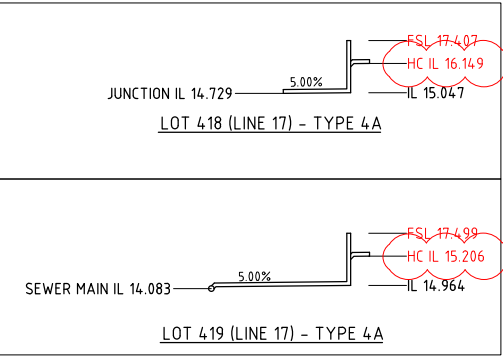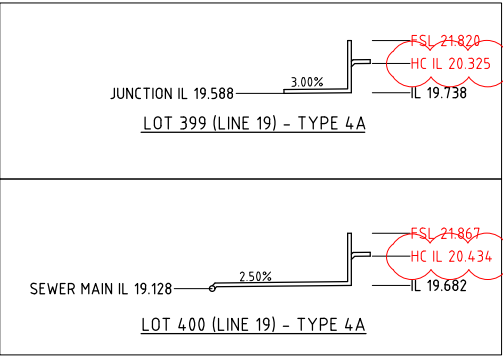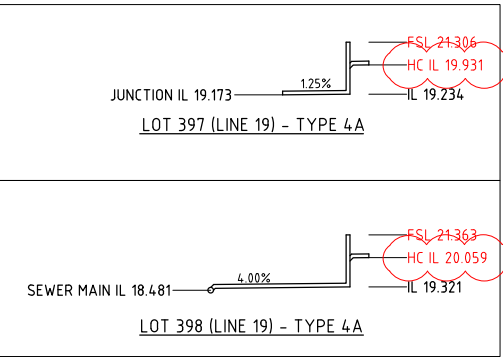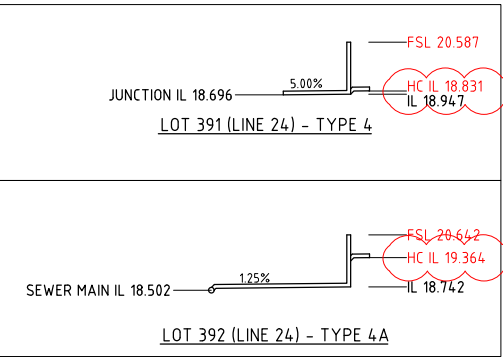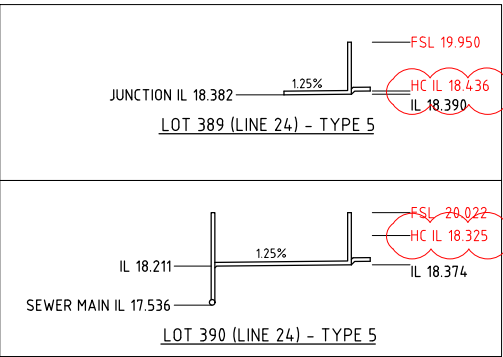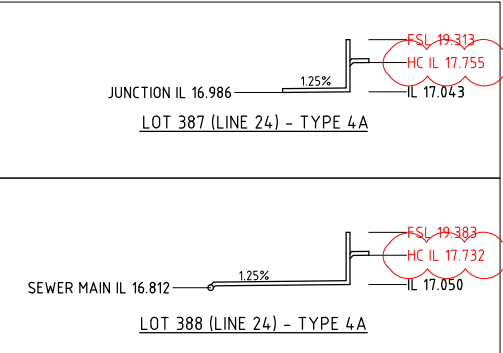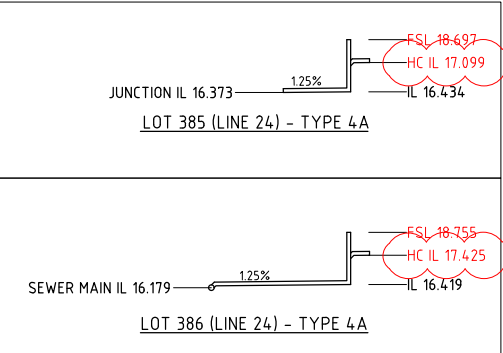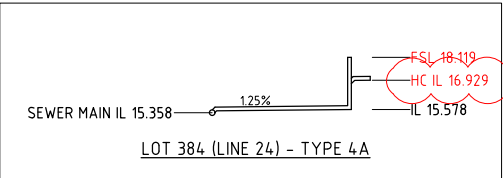

On behalf of WATER SERVICES, for  
incorporation into POWER WATER CORP'S network.  
THIS DRAWING IS APPROVED FOR THE  
CONSTRUCTION OF ALL WATER & SEWER COMPONENTS  
AS SHOWN ON THE DRAWINGS  
This approval does not relieve the developer and consultant  
from full responsibility for the correctness of the design  
and associated documents  
This drawing is valid only for 2 years from date of signing

SIGNED \_\_\_\_\_ DATE \_\_\_\_\_

1	AS CONSTRUCTED	MC	LW	WS	21/06/18
0	FOR CONSTRUCTION	MC	LW	WS	22/01/18
No.	Amendments	Drawn	Design	Appd	Registered Engineer Reg No. Date
This drawing cannot be copied or reproduced in any form or used for any purpose other than that originally intended without the written permission of Empower Engineers and Project Managers ©COPYRIGHT 2018					




Client	URBEX AND LAND DEVELOPMENT CORP. (JV)			Datum	
Project	ZUCCOLI PHASE 3.3			AHD	
Title	SEWERAGE RETICULATION HOUSE CONNECTION DETAILS			PSM	
				RL	
				(MGA) COORD	
	Project No.	Drawing No.	Rev	AS CONSTRUCTED	
	B00176-CS006		1		

POWER WATER CORP. DRG No. B17-9039

LEGEND

- 300 AS CONSTRUCTED Ø300 WATER MAIN  
225 AS CONSTRUCTED Ø225 WATER MAIN  
150 AS CONSTRUCTED Ø150 WATER MAIN

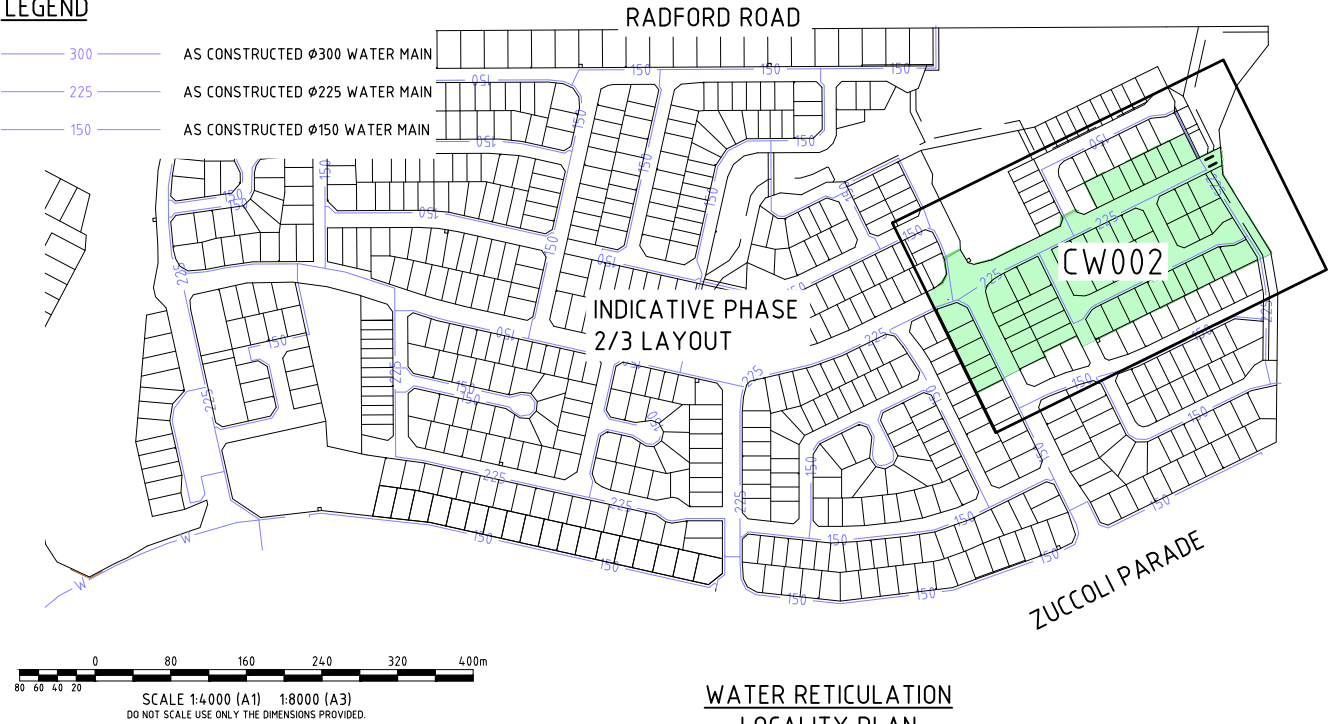

WATER RETICULATION  
LOCALITY PLAN  
SCALE 1:4,000


AS CONSTRUCTED  
INFORMATION CERTIFIED BY  
BMD URBAN PTY LTD

SIGNED: [Signature] DATED: 03/07/2018


NOMINAL PIPE DIAMETER	W
100 & 150	450
200-300	600
375	750
450	900
450-900	PIPE OD + 600
1050-1500	PIPE OD + 700
1650-4000	15 x PIPE OD

NOMINAL PIPE SIZE	B1	C
20-50	100	150
80-100	100	150
150-600	150	150
750 & LARGER	200	200


GEOTEXTILE FABRIC WITH AUSTRROADS G RATING OF 1200 MIN. & NOMINAL OPENING SIZE 220µm MAX. MINIMUM OVERLAP OF 500mm AT ALL JOINTS

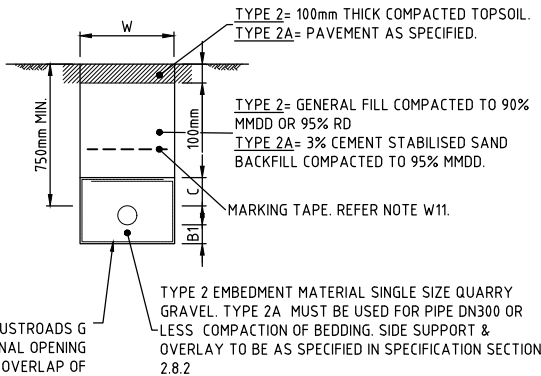

TYPE 2/2A TRENCH DETAIL  
SCALE N.T.S

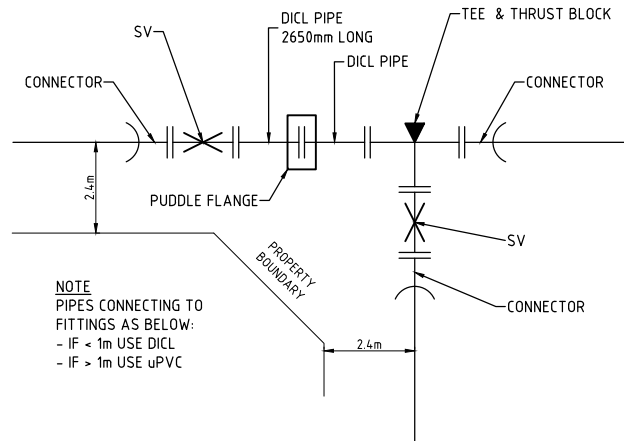

TYPICAL BRANCH DETAIL  
N.T.S.  
ALL BENDS ARE DI CL (SQC-SQC) UNLESS SHOWN OTHERWISE IN A SCHEMATIC DETAIL.

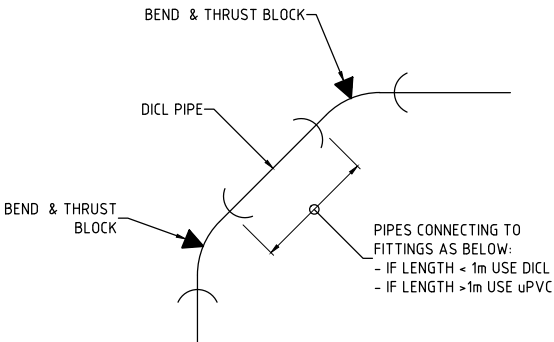

TYPICAL MULTI-BEND DETAIL  
N.T.S.  
NOTE: FOR MAIN & FITTINGS REFER PLAN DRG'S

POWER AND WATER STANDARD NOTES

GENERAL

- WS.1.** CONSTRUCTION OF THE WATER AND SEWERAGE WORKS ARE CARRIED OUT IN ACCORDANCE WITH THE LATEST AMENDMENT OF THE APPROVED PROJECT DRAWINGS AND SPECIFICATION, AS SIGNED BY A SERVICES DEVELOPMENT OFFICER, AND THE POWER AND WATER CONNECTION CODE POWER AND WATER MASTER SPECIFICATION AND ASSOCIATED DOCUMENTS.
- WS.2.** CONSTRUCTION SITE DESIGN DRAWINGS MUST BE SIGNED AS 'APPROVED FOR CONSTRUCTION' BY A POWER AND WATER SERVICES DEVELOPMENT OFFICER.
- WS.3.** PRIOR TO COMMENCEMENT OF WORKS THE CONSTRUCTOR CHECKED THE LOCATION OF ALL UNDERGROUND SERVICES, AND CONFIRM FINISHED SURFACE LEVELS AND CHECK THE MATERIAL, DIAMETER, ALIGNMENT, LEVEL AND LOCATION OF EXISTING PIPEWORK AT THE CONNECTION POINT. IT IS NOT GUARANTEED THAT ALL SERVICES HAVE BEEN SHOWN ON THE DRAWINGS.
- WS.4.** CHANGES REQUESTED BY ANY PARTY TO THE DESIGN OF THE WORKS DURING ANY STAGE OF THE DEVELOPMENT ARE ENDORSED BY THE CERTIFYING HYDRAULIC CONSULTING ENGINEER/DESIGNER WITH AMENDED DRAWINGS SUBMITTED TO POWER AND WATER FOR APPROVAL PRIOR TO THE CHANGE BEING CARRIED OUT.
- WS.5.** SEVEN (7) DAYS WRITTEN NOTICE HAS BEEN GIVEN TO SERVICES DEVELOPMENT, POWER AND WATER, WITH A 'NOTICE OF INTENTION TO START WORK' PRIOR TO COMMENCEMENT OF WORK (FORM AVAILABLE ON THE CONNECTION CODE WEBSITE).
- WS.6.** THE CONTRACTOR CONFIRMED WITH SERVICES DEVELOPMENT IF A MEETING IS REQUIRED WITH POWER AND WATER, THE HYDRAULIC CERTIFIER AND THE DEVELOPER PRIOR TO COMMENCEMENT OF SITE WORKS.
- WS.7.** EXISTING SERVICE CONNECTIONS REMAINED IN SERVICE UNTIL THE CONSTRUCTION OF THE NEW SERVICE IS COMPLETED TO THE SATISFACTION OF POWER AND WATER.
- WS.8.** ALL LEVELS GIVEN ARE TO AUSTRALIAN HEIGHT DATUM (AHD) IN METRES TO THREE DECIMAL PLACES. PROJECTION BASED ON MGA94 MAP GRID OF AUSTRALIA ZONE 52 OR 53 COORDINATE SYSTEM.
- WS.9.** ALL DIMENSIONS ARE IN MILLIMETRES AND ALL CHAINAGES AND LEVELS LEVEL IN METRES UNLESS SHOWN OTHERWISE.
- WS.10.** MINIMUM COVER TO PIPE IS 750MM IN TRAFFICABLE AREAS, 600mm IN OTHER AREAS. 1500mm COVER REQUIRED FOR THRUST BORING UNDER ROAD.
- WS.11.** MINIMUM CLEARANCES BETWEEN UNDERGROUND SERVICES IS AS PER WSA 02-2003 TABLE 4.2 FOR SEWER, AND WSA 03-2003 TABLE 4.1 FOR WATER. A MINIMUM VERTICAL CLEARANCE OF 300mm FOR ALL SERVICE CROSSINGS IS TO BE MAINTAINED.

EXCAVATION AND FILLING

- WS.12.** OBTAIN PERMIT/S FROM THE RELEVANT ROAD AUTHORITY OR COUNCIL PRIOR TO ANY EXCAVATION WITHIN THE ROAD RESERVE. THE CONTRACTOR/DEVELOPER IS REQUIRED TO SEEK A WRITTEN APPROVAL FORM THE LAND OWNER OF THE EXISTING EASEMENT TO ACCESS AND EXCAVATE WITHIN THEIR PROPERTY. THE CONTRACTOR/DEVELOPER IS REQUIRED TO SUPPLY THAT WRITTEN APPROVAL TO POWER AND WATER SEVEN (7) DAYS PRIOR TO THE START OF CONSTRUCTION WORKS.
- WS.13.** BACKFILLING MATERIAL, OUTSIDE ROAD PAVEMENT OR DRAIN, MUST COMPLY WITH THE POWER AND WATER MASTER SPECIFICATION REQUIREMENTS FOR GENERAL BACKFILL. USE TYPE 2 EMBEDMENT WRAPPED WITH GEOTEXTILE WITH SELECTED BACKFILL OR 3% CEMENT STABILISED SAND BACKFILL FOR ALL ROAD CROSSINGS. USE 5% CEMENT STABILISED GRAVEL BACKFILL BENEATH ALL OUD CROSSING.
- WS.14.** PROVIDE A MINIMUM OF TYPE 2 EMBEDMENT FOR PVC PIPE OR TYPE 4 EMBEDMENT FOR STEEL PIPE UNLESS GEOTECHNICAL INVESTIGATIONS HAVE BEEN COMPLETED AND THE CONSULTANT REPORT SUPPORTS THE USE OF LOWER QUALITY EMBEDMENT. ANY CHANGE TO THE PROPOSED BEDDING TYPE MUST BE APPROVED BY POWER AND WATER.
- WS.15.** WHEN EMBEDMENT TYPE CHANGES, A VERTICAL GEOTEXTILE BARRIER ARE INSERTED BETWEEN THE EMBEDMENT TYPES.
- WS.16.** REINSTATE ALL SURFACES UPON COMPLETION OF THE WORKS AS SPECIFIED OR AS GOOD AS EXISTING TO THE SATISFACTION OF THE RELEVANT AUTHORITY.

COMMISSIONING

POWER WATER CORPORATION - WATER STANDARD DRAWINGS	
W1-1-01/7	WATER 20mm WATER SERVICE COPPER
W1-1-02/7	WATER 25mm WATER SERVICE COPPER
W1-1-04/10	WATER 50mm WATER SERVICE COPPER
W1-1-16/1	DN100 - 300 WATER MAINS TYPICAL DETAILS BRANCH OFF MAINS
W1-1-23/1	CONNECTIONS TO MAINS DN20, DN25 AND DN50
W1-1-24/3	PROPERTY CONNECTIONS DN80, DN100 AND DN150
W1-2-03A/4	BS750 SCREW DOWN HYDRANT INSTALLATION IN NATURE STRIP OFF DN100 - DN 300 MAINS
W1-2-03C/3	BS750 SCREW DOWN HYDRANT AND SLUICE VALVE INSTALLATION IN ROADWAY
W1-2-03D/1	STOP (ISOLATING) VALVES LOCATION MARKING
W1-2-03F/3	BS750 SCREW DOWN HYDRANT KERB MARKING AND MARKER POST DETAILS
W1-2-03H/2	WATER MAINS LOCATION MARKING
W1-2-03J/2	SLUICE VALVE INSTALLATION IN NATURE STRIP
W1-2-05/0	THRUST BLOCK AND TRENCH DETAILS FOR DN100 - 225 PRESSURE MAIN
W1-2-06/0	STANDARD WELDED STEEL PIPE FITTINGS
W1-2-07/1	HYDROSTATIC TESTING PROCEDURE FOR WATER MAINS
W1-2-17A/1	APPLICATION OF POLYETHYLENE SLEEVING FOR CORROSION PROTECTION OF DI CL PIPE
W1-2-17B/2	APPLICATION OF POLYETHYLENE SLEEVING FOR CORROSION PROTECTION OF DI CL FITTINGS
W1-2-18/0	WATER MAINS AND SERVICES KERB MARKERS FOR ROAD CROSSINGS
W1-2-19/1	TEMPORARY DEAD ENDS DN100 - DN450

CONTRACTOR TO CONFIRM THAT THE LATEST REVISIONS ARE USED FOR CONSTRUCTION

WARNING  
BEWARE OF SERVICES

THE LOCATIONS OF ALL EXISTING SERVICES ARE APPROXIMATE ONLY AND THEIR EXACT POSITION SHOULD BE PROVEN ON SITE BY CONTRACTOR. NO GUARANTEE IS GIVEN THAT ALL EXISTING SERVICES ARE SHOWN.

On behalf of WATER SERVICES, for incorporation into POWER WATER CORP'S network.

THIS DRAWING IS APPROVED FOR THE CONSTRUCTION OF ALL WATER & SEWER COMPONENTS AS SHOWN ON THE DRAWINGS  
This approval does not relieve the developer and consultant from full responsibility for the correctness of the design and associated documents  
This drawing is valid only for 2 years from date of signing

SIGNED DATE

- WS.17.** SIGNED HARD COPY (A3 SIZE - REQUIRED FOR ALL SUBDIVISIONS) AND ELECTRONIC FORMAT (BOTH x.PDF AND CAD x.DGN/x.DWG) 'AS-CONSTRUCTED' DRAWINGS, OTHER INSTALLATION DOCUMENTATION, AND APPROPRIATE RECORDS OF CONSTRUCTION PROGRESS (PHOTOS) MUST BE PROVIDED TO SERVICES DEVELOPMENT, POWER AND WATER PRIOR TO HANDOVER INSPECTION. ENSURE ALL AS-CONSTRUCTED INFORMATION HAS BEEN PICKED UP BY THE SURVEYOR PRIOR TO BACKFILLING.
- WS.18.** 'AS-CONSTRUCTED' DRAWINGS TO BE CERTIFIED BY THE CERTIFYING ENGINEER. 'AS-CONSTRUCTED' SURVEY BY A REGISTERED SURVEYOR.
- WS.19.** DESIGNER TO CONTACT SERVICES DEVELOPMENT, POWER AND WATER, TO ARRANGE FOR HANDOVER INSPECTIONS. SEVEN (7) DAYS NOTICE MUST BE PROVIDED PRIOR TO HANDOVER INSPECTIONS.
- WS.20.** THE CONSTRUCTOR IS RESPONSIBLE FOR ALL CONNECTION FEES, ALL EXCAVATION, SHORING IF REQUIRED, BACKFILLING, REINSTATEMENT OF AREA, SUPPLY OF DIGGING AND LIFTING MACHINERY WHERE REQUIRED, PERMITS, TRAFFIC CONTROL, SUPPLY OF ALL MATERIALS, PIPES AND FITTINGS.
- WS.21.** POWER AND WATER PERSONNEL SHALL INSTALL ALL NEW WATER CONNECTIONS TO EXISTING MAINS. ENSURE REQUIRED WATER CONNECTION FITTINGS ARE BOLTED TOGETHER AND READY TO BE INSTALLED UPON SHUTDOWN. THE WATER CONNECTION ARE COMPLETED PRIOR TO THE CONSTRUCTION OF THE NEW WATER SERVICE. THIS IS ONLY ALLOWED IF A VALVE LOCK IS INSTALLED BY POWER AND WATER CORPORATION ON THE SLUICE VALVE TO THE WATER MAIN. PRESSURE TESTING AGAINST THE SLUICE VALVE IS PERMITTED TO A MINIMUM OF 1000KPA AND A MAXIMUM PRESSURE OF 1200KPA UNLESS PREVIOUSLY SPECIFIED. IF THE CONSTRUCTOR SUSPECTS THE SLUICE VALVE IS LEAKING UNDER PRESSURE TESTING THEN CONTACT THE SUPPLIER FOR REPLACEMENT. THE VALVE LOCK WILL BE REMOVED BY POWER AND WATER AFTER THE HANDOVER OF THE ASSET HAS BEEN ACHIEVED.
- WS.22.** POWER AND WATER PERSONNEL SHALL INSTALL ALL NEW SEWER CONNECTIONS TO EXISTING MAINS. A PHYSICAL ISOLATION MUST BE IN PLACE BETWEEN THE EXISTING LIVE SEWER AND THE PROPOSED GIFTED ASSET. THE PHYSICAL ISOLATION DEVICE WILL BE REMOVED BY POWER AND WATER AFTER THE HANDOVER OF THE ASSET HAS BEEN ACHIEVED.
- WS.23.** AT NO STAGE SHALL ANY CONTRACTOR CARRY OUT WORK ON POWER AND WATER INFRASTRUCTURE.
- ACCEPTANCE AND DEFECTS LIABILITY PERIOD**
- WS.24.** AT LEAST SEVEN (7) WORKING DAYS NOTICE MUST BE PROVIDED TO SERVICES DEVELOPMENT, POWER AND WATER FOR APPLICATION OF A CERTIFICATE OF FINAL COMPLIANCE/DEVELOPMENT PERMIT CLEARANCE ALLOWING FOR AN INSPECTION AND REPORT OF OUTSTANDING DEFECTS/ISSUES. UPON NOTICE TO SERVICES DEVELOPMENT THAT RECTIFICATION OF OUTSTANDING DEFECTS/ISSUES HAS BEEN ADDRESSED, AN ADDITIONAL SEVEN (7) WORKING DAYS SHOULD BE ALLOWED FOR.
- WS.25.** A TWENTY-FOUR (24) MONTH DEFECTS LIABILITY PERIOD FOR EXTENSIONS AND SUBDIVISIONS, AND A TWELVE (12) MONTH DEFECTS LIABILITY PERIOD FOR BUILDING DEVELOPMENTS, WILL COMMENCE ONCE THE CERTIFICATE OF FINAL COMPLIANCE/DEVELOPMENT PERMIT CLEARANCE HAS BEEN ISSUED. ALL DEFECT LIABILITIES IDENTIFIED WITHIN THIS PERIOD IS THE RESPONSIBILITY OF THE DEVELOPER. ANY WORKS SUBJECT TO A DEFECT DURING THE DEFECT PERIOD THAT REQUIRES POWER AND WATER TO UNDERTAKE AN EMERGENCY REPAIR, ARE SUBJECT TO AN EXTENDED DEFECT PERIOD OF 5 YEARS.

POWER AND WATER (WATER NOTES)

- W.1.** WATER PIPES ARE BURIED PVC-M SERIES 2 CLASS 16, WITH DI CL FITTINGS, UNLESS NOTED OTHERWISE.
- W.2.** ALL DUCTILE IRON CEMENT LINED (DI CL) PIPES ARE CLASS PN16 FLANGED OR CLASS 35 RUBBER RING JOINTED (RRJ). ALL BURIED DI CL PIPES AND FITTINGS ARE WRAPPED IN POLYETHYLENE SLEEVING BEFORE AND DURING INSTALLATION. MARKINGS ON PIPES SHALL FACE UPWARDS.
- W.3.** PIPES UNDER ROAD PAVEMENT, OPEN DRAIN AND DRAINAGE STRUCTURES ARE DI CL CLASS 16 FLANGE JOINTED OR CLASS 35 TYTON-LOK, RRJ.
- W.4.** PROVIDE ANCHORAGE FOR ALL VALVES, REDUCERS, VERTICAL BENDS AND TERMINAL /END POINTS. PROVIDE THRUST BLOCK FOR ALL HORIZONTAL BENDS AND TEES.
- W.5.** ALL SLUICE VALVES ARE RESILIENT SEATED FLANGED CLASS 16 TO POWER AND WATER STANDARDS WITH RAISED FLANGES, UNLESS NOTED OTHERWISE.
- W.6.** ALL FLANGES ARE CLASS 16 RAISED TYPE COMPLYING WITH AS.4087 FIGURE B5 FOR DI CL AND FIGURE B7 FOR MSCL, UNLESS NOTED OTHERWISE.
- W.7.** WATER MAINS ARE OFFSET FROM PROPERTY BOUNDARIES A DISTANCE OF 2.4m IN ROAD RESERVES AND 1.5m IN PRIVATE PROPERTY, EXCEPT WHERE SHOWN OTHERWISE ON THE DRAWINGS.
- W.8.** THE COATING ON THE FITTINGS ARE FULLY PROTECTED BY A FELT OR GEOTEXTILE BARRIER WHEN THE THRUST BLOCK IS POURED AND THRUST BLOCKS MUST NOT OVERLAP THE JOINT.
- W.9.** WATERMAINS ARE LAID OVER STORM WATER, SEWER, NON-POTABLE AND RECYCLED WATER PIPES.
- W.10.** OINT DEFLECTION AND BENDING ARE NOT ALLOWED FOR PVC PIPES. USE SO-SO DI CL CONNECTORS TO ACHIEVE A MAXIMUM 2 DEGREE JOINT DEFLECTION OR BENDS FOR LARGER DEFLECTION.
- W.11.** MARKING TAPE COLOURED GREEN AND MARKED 'WATER MAIN' ARE LAID CONTINUOUSLY AND LOCATED 300MM ABOVE THE WATER PIPEWORK.
- W.12.** HYDROSTATIC TEST PRESSURE ARE 1000KPA FOR RETICULATION MAINS AND 1200KPA FOR DI CL OR MSCL DISTRIBUTION MAINS OVER A 4 HOUR PERIOD. HYDROSTATIC TEST ARE IN ACCORDANCE WITH POWER AND WATER STANDARD DRAWING W1-2-07.
- W.13.** CONNECTIONS TO EXISTING WATER MAINS WILL ONLY BE CARRIED OUT WHEN ALL WORKS AND TESTING (HYDROSTATIC TESTING, DISINFECTION FLUSHING AND MICROBIOLOGICAL TEST) ARE COMPLETE IN ACCORDANCE WITH THE APPROVED DESIGN DRAWINGS AND PROCEDURES, AND HAVE SATISFACTORILY PASSED FINAL HANDOVER INSPECTION.


ADDITIONAL WATER NOTES

- W.101.** THE SUPERINTENDENT IN CONSULTATION WITH GEOTECHNICAL PERSONNEL DETERMINED WATER PIPE BEDDING TYPE AFTER INSPECTION OF THE EXCAVATED TRENCH. TYPE 2A BEDDING AND GEOTEXTILE FABRIC ARE USED UNDER ROADS AND AT OTHER LOCATIONS AS SHOWN ON THE DRAWINGS. **ALL ROAD CROSSINGS ARE BACKFILLED TO A STRINGENT COMPACTION STANDARD, USING A CEMENT STABILISED SAND FOR THE FULL WIDTH OF THE TRENCH TO SUBGRADE LEVEL.**
- W.102.** HYDRANTS ARE BS750 SCREW-DOWN TYPE - BS750 - 1977 THREAD IN ACCORDANCE WITH PWC STD DRG W1-2-03A.
- W.103.** ALL SERVICE CONNECTIONS ARE DN20 U.N.O. REFER PWC STD DRG W1-1-01.
- W.104.** DUPLEX SERVICE CONNECTION ARE DN 25, FOR DETAILS REFER PWC STD DRG W1-1-29. WHERE DUPLEX SITE IS GREATER THAN 800m<sup>2</sup> IN AREA, THE CONNECTION ARE DN50. REFER PWC STD DRG W1-1-27.
- W.105.** TRIPLEX SERVICE CONNECTION ARE DN 50, FOR DETAILS REFER PWC STD DRG W1-1-27.
- W.106.** TRENCHTOPS OR BULKHEADS ARE CONSTRUCTED IN ACCORDANCE WITH WSA STANDARD DRAWING WAT-1209 WHERE WATERMAIN GRADE EXCEEDS 5%.


POWER WATER CORP. DRG No. B17-9040



Client	URBEX AND LAND DEVELOPMENT CORP. (JV)		Datum AHD PSM RL (MGA) COORD	
Project	ZUCCOLI PHASE 3.3			
Title	WATER RETICULATION LOCALITY PLAN AND NOTES		AS CONSTRUCTED	
Project No.			Drawing No.	Rev
B00176-CW001				1

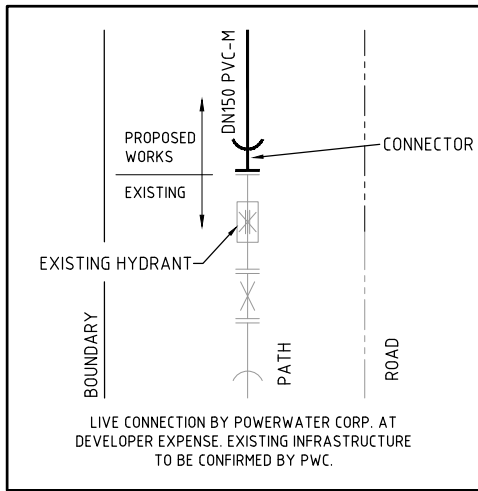

CONNECTION DETAIL A  
N.T.S.

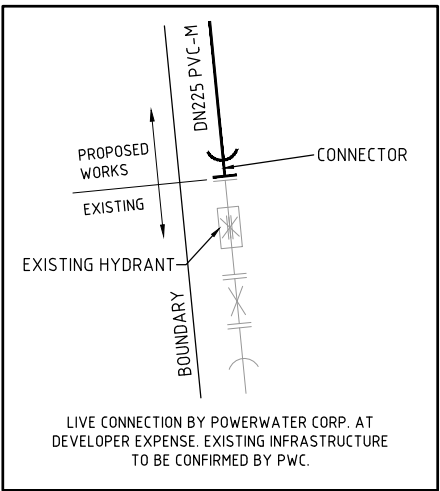

CONNECTION DETAIL B  
N.T.S.

AS CONSTRUCTED  
INFORMATION CERTIFIED BY  
BMD URBAN PTY LTD

SIGNED:  DATED: 03/07/2018

On behalf of WATER SERVICES, for  
incorporation into POWER WATER CORP'S network.

THIS DRAWING IS APPROVED FOR THE  
CONSTRUCTION OF ALL WATER & SEWER COMPONENTS  
AS SHOWN ON THE DRAWINGS













This approval does not relieve the developer and consultant  
from full responsibility for the correctness of the design  
and associated documents


This drawing is valid only for 2 years from date of signing

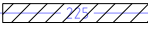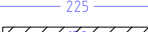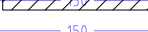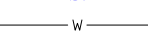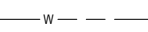SIGNED: \_\_\_\_\_ DATE: \_\_\_\_\_

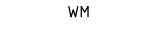**WARNING**  
**BEWARE OF SERVICES**

THE LOCATIONS OF ALL EXISTING SERVICES  
ARE APPROXIMATE ONLY AND THEIR EXACT  
POSITION SHOULD BE PROVEN ON SITE BY  
CONTRACTOR. NO GUARANTEE IS GIVEN  
THAT ALL EXISTING SERVICES ARE SHOWN.

- LEGEND**
-  AS CONSTRUCTED PROPOSED Ø225 DICL WATER MAIN
  -  225 AS CONSTRUCTED PROPOSED Ø225 WATER MAIN
  -  150 AS CONSTRUCTED PROPOSED Ø150 DICL WATER MAIN
  -  150 AS CONSTRUCTED PROPOSED Ø150 WATER MAIN
  -  W FUTURE WATER MAIN
  -  W EXISTING TRUNK WATER MAIN
  -  C WATER CONDUIT CROSSINGS
  -  NOMINAL FACE OF KERB
  -  WM AS CONSTRUCTED WATER SERVICE POINT OF ENTRY (INDICATIVE ONLY)
  -  150 AS CONSTRUCTED SLUICE VALVE
  -  150 AS CONSTRUCTED FIRE HYDRANT
  -  AS CONSTRUCTED PHASE BOUNDARIES

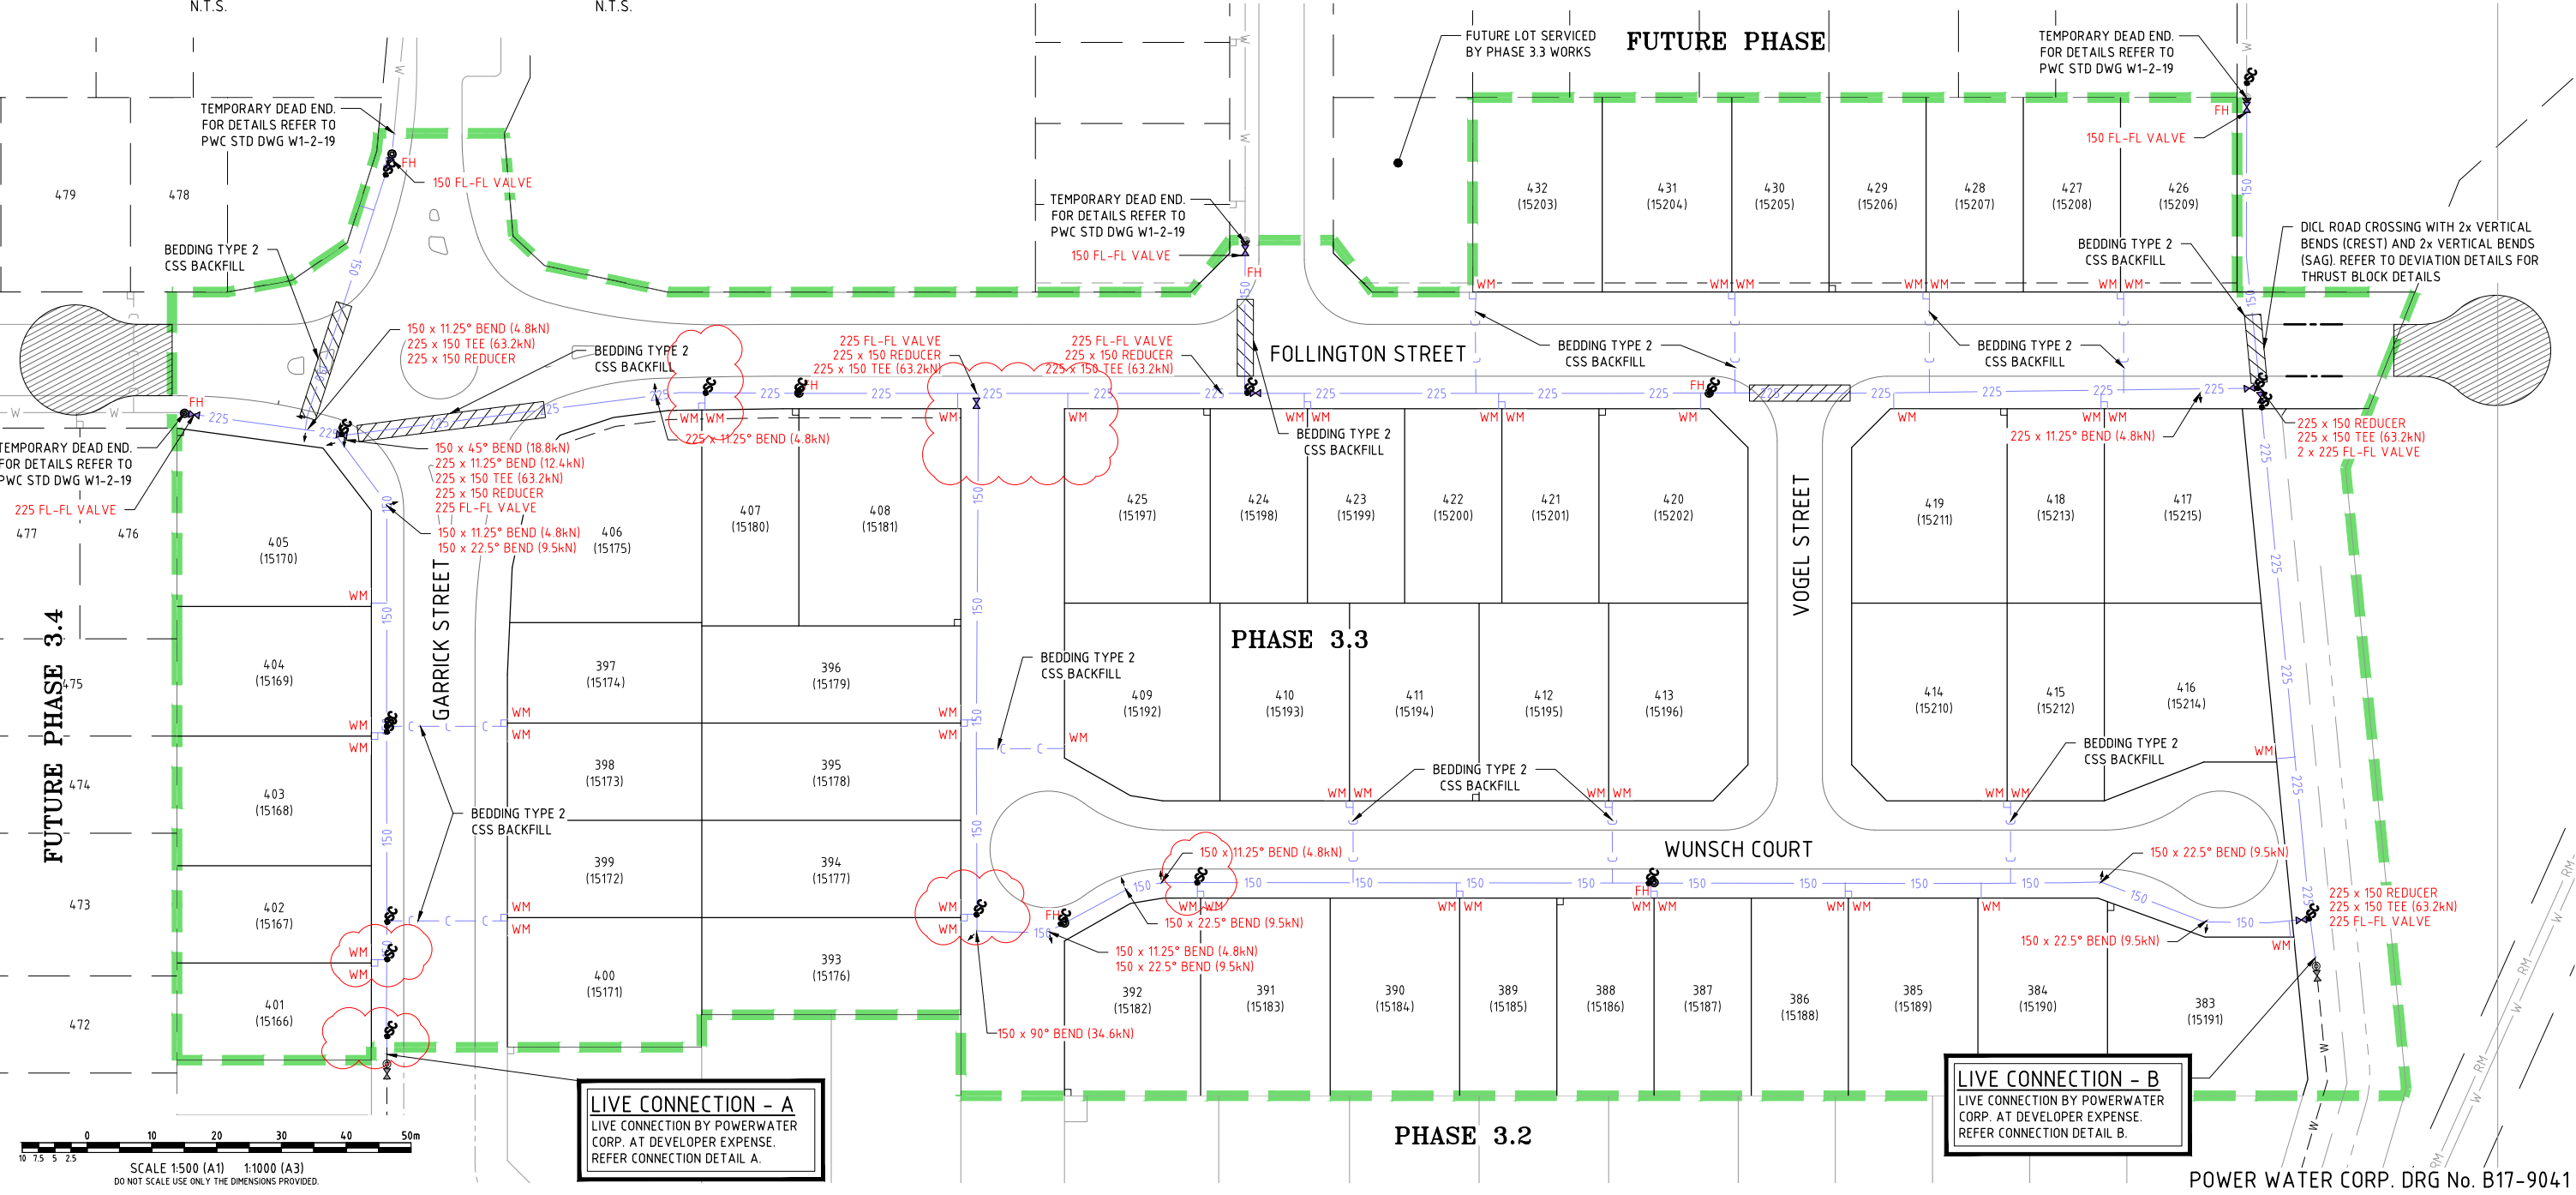

**LIVE CONNECTION - A**  
LIVE CONNECTION BY POWERWATER  
CORP. AT DEVELOPER EXPENSE.  
REFER CONNECTION DETAIL A.

**LIVE CONNECTION - B**  
LIVE CONNECTION BY POWERWATER  
CORP. AT DEVELOPER EXPENSE.  
REFER CONNECTION DETAIL B.


POWER WATER CORP. DRG No. B17-9041

1	AS CONSTRUCTED	AQ	LW	WS	21/06/18
0	FOR CONSTRUCTION	MC	LW	WS	22/01/18
No.	Amendments	Drawn	Design	Appd	Registered Engineer Reg No. Date

This drawing cannot be copied or reproduced in any form or used for any purpose other than that originally intended without the written permission of Empower Engineers and Project Managers ©COPYRIGHT 2018



Client	URBEX AND LAND DEVELOPMENT CORP. (JV)	Datum	AHD
Project	ZUCCOLI PHASE 3.3	PSM	RL
Title	WATER RETICULATION LAYOUT PLAN	(MGA) COORD	
Project No.	B00176-CW002	Drawing No.	1
Rev			

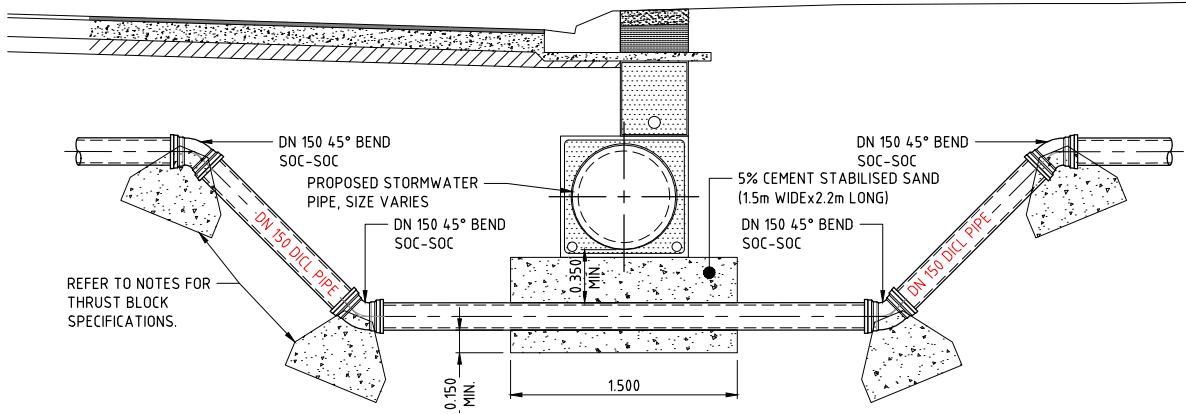

TYPICAL WATER MAIN DEVIATION DETAIL  
SCALE 1:25

THRUST BLOCK NOTES


1. REFER PWC STD. DWG. W1-2-05 FOR DN150 THRUST BLOCK DETAILS.
2. UNLESS NOTED OTHERWISE, REFER TO DETAILS ON THIS DRAWING AND WSAA STD. DWG. WAT-1205 AND WAT-1207 FOR DN150 THRUST BLOCK DETAILS.
3. **CONTRACTOR TO CONFIRM THE SOIL BEARING CAPACITY PRIOR TO THE CONSTRUCTION OF THE THRUST BLOCK**

MINIMUM THRUST AREA FOR ANCHORAGE IN m<sup>2</sup> WITH TEST PRESSURE 1000 kPa

FOR HORIZONTAL THRUST ON TRENCH WALLS WHERE THE COVER OVER PIPES IS 450mm OR GREATER	90° & 60° HORIZ. BENDS	45° & 30° HORIZ. BENDS	22.5° HORIZ. BENDS	11.25° HORIZ. BENDS	TEES & DEAD ENDS
	STIFF CLAY, MEDIUM DENSE CLEAN SAND	VERY STIFF CLAY, DENSE SAND / GRAVEL, DECOMPOSED ROCK	STIFF CLAY, MEDIUM DENSE CLEAN SAND	STIFF CLAY, MEDIUM DENSE CLEAN SAND	STIFF CLAY, MEDIUM DENSE CLEAN SAND
PBH kPa	50	100	200	50	100
φ150	0.70	0.35	0.18	0.38	0.19


MINIMUM BLOCK VOLUME FOR ANCHORAGE OF VERTICAL COMPONENT OF THRUST

PIPE DN	CONCRETE VOLUME m <sup>3</sup>		
	11.25° BENDS	22.5° BENDS	45° BENDS
φ150	0.2	0.4	0.75

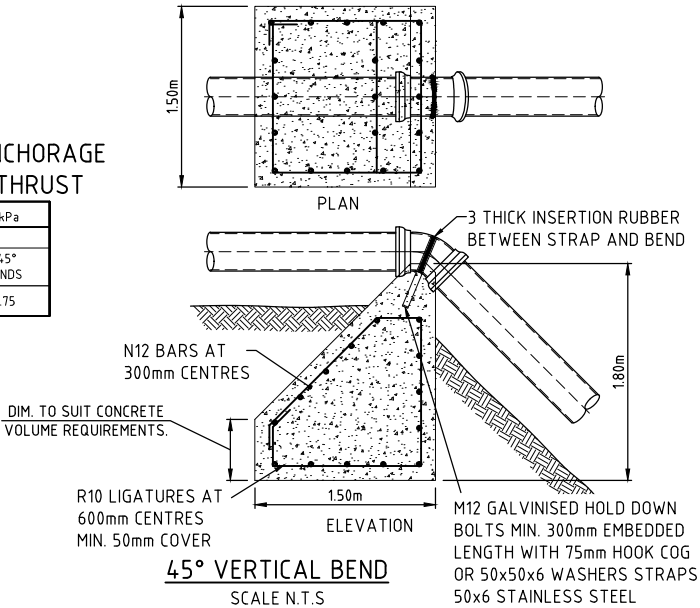

AS CONSTRUCTED  
INFORMATION CERTIFIED BY  
BMD URBAN PTY LTD

SIGNED:  DATED: 03/07/2018

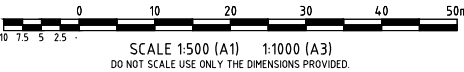

POWER WATER CORP. DRG No. B17-13293



Client	URBEX AND LAND DEVELOPMENT CORP. (JV)			Datum	AHD	PSM	RL	(MGA) COORD
Project	ZUCCOLI PHASE 3.3			AS CONSTRUCTED				
Title	WATER RETICULATION DETAILS PLAN			Project No.	Drawing No.	Rev		
				B00176-CW003		1		