


JOINS RIGHT

ROAD NO. 24 (FOLLINGTON STREET)

JOINS LEFT

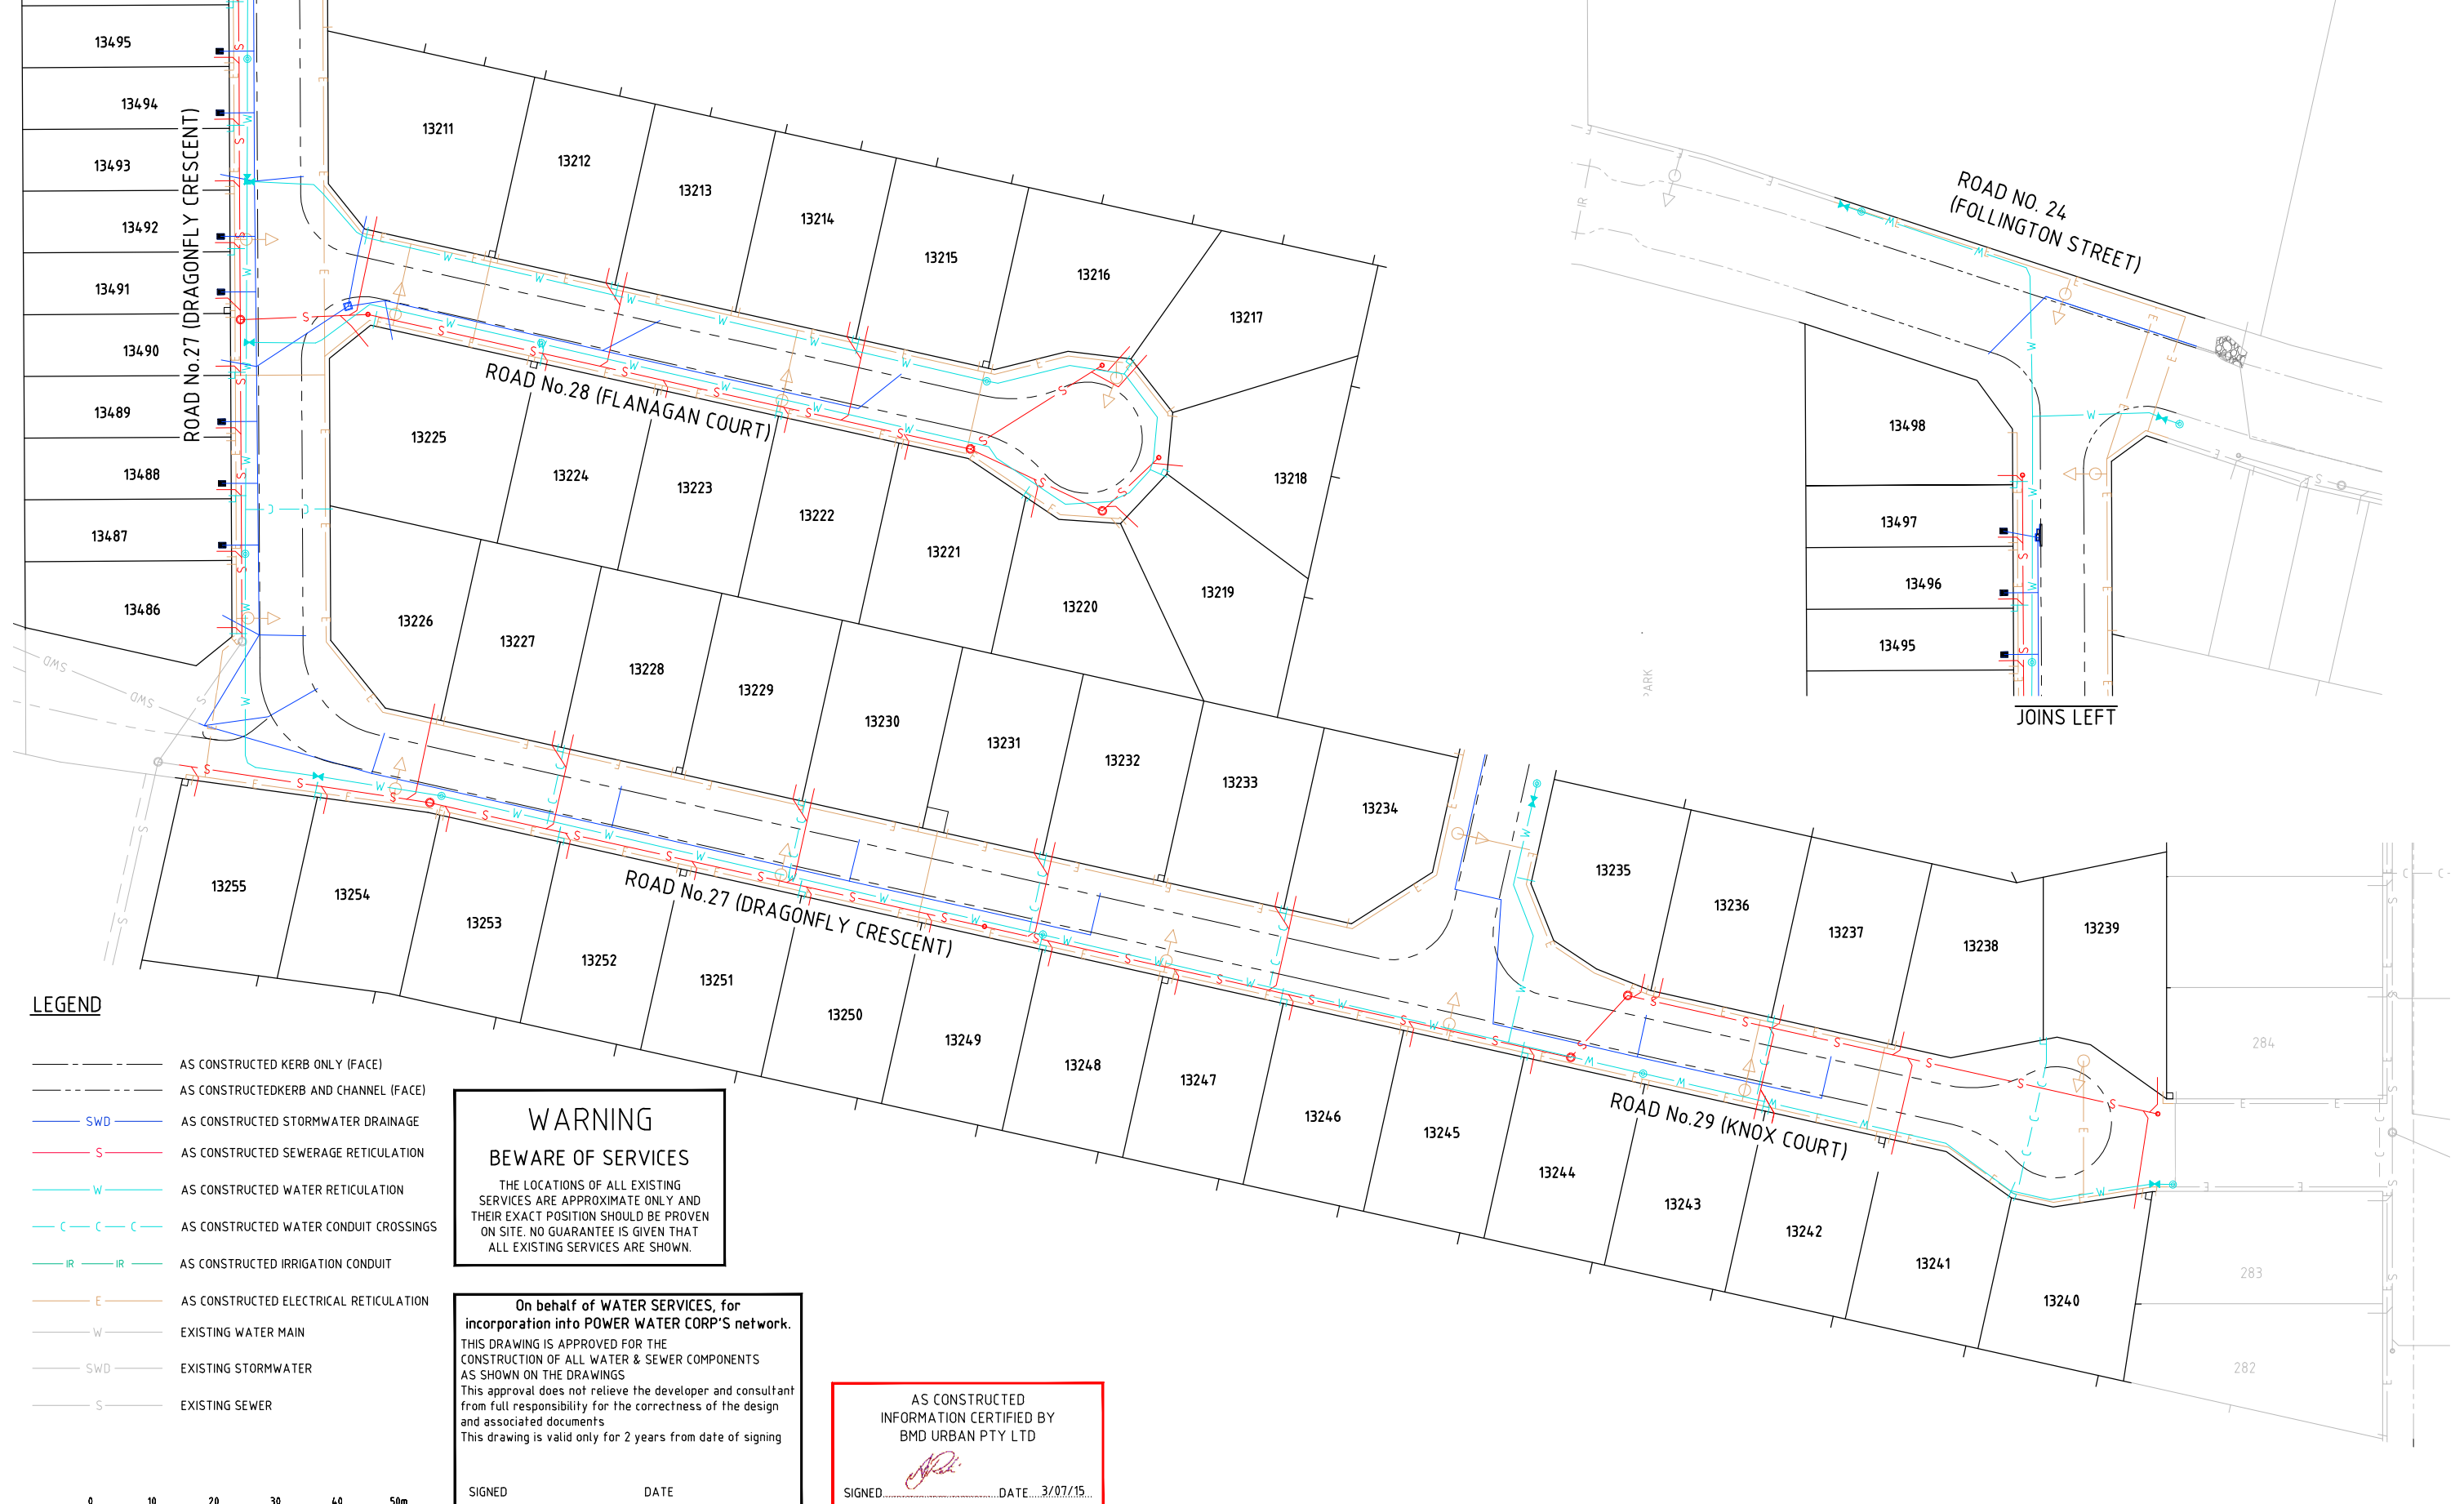

- LEGEND**
- AS CONSTRUCTED KERB ONLY (FACE)
 - AS CONSTRUCTED KERB AND CHANNEL (FACE)
 - SWD AS CONSTRUCTED STORMWATER DRAINAGE
 - S AS CONSTRUCTED SEWERAGE RETICULATION
 - W AS CONSTRUCTED WATER RETICULATION
 - C-C AS CONSTRUCTED WATER CONDUIT CROSSINGS
 - IR-IR AS CONSTRUCTED IRRIGATION CONDUIT
 - E AS CONSTRUCTED ELECTRICAL RETICULATION
 - W EXISTING WATER MAIN
 - SWD EXISTING STORMWATER
 - S EXISTING SEWER


WARNING
BEWARE OF SERVICES
 THE LOCATIONS OF ALL EXISTING SERVICES ARE APPROXIMATE ONLY AND THEIR EXACT POSITION SHOULD BE PROVEN ON SITE. NO GUARANTEE IS GIVEN THAT ALL EXISTING SERVICES ARE SHOWN.

On behalf of WATER SERVICES, for incorporation into POWER WATER CORP'S network.
 THIS DRAWING IS APPROVED FOR THE CONSTRUCTION OF ALL WATER & SEWER COMPONENTS AS SHOWN ON THE DRAWINGS
 This approval does not relieve the developer and consultant from full responsibility for the correctness of the design and associated documents
 This drawing is valid only for 2 years from date of signing

SIGNED _____ DATE _____

AS CONSTRUCTED
 INFORMATION CERTIFIED BY
 BMD URBAN PTY LTD

SIGNED *[Signature]* DATE 3/07/15

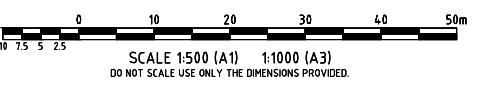

File Name: B:\Brisbane - Consulting\085\B00104\B00114_Zuccoli Phase 2.4\14_CIVIL - DRGS\14.5 AS CON\Zuccoli Phase 2.4\B00114-ASCON-2.4-SERV
 User: JASON KING
 Plot Date: 21/02/2015 9:56:16 AM

POWER WATER CORP. DRG No. B14-10886

3	AMENDED LOT NUMBERS	JK	JK	MKB	24/07/15
2	AS CONSTRUCTED	JK	JK	MKB	03/07/15
1	ISSUED FOR CONSTRUCTION	JK	PDW	MKB	20/02/15
A	ORIGINAL ISSUE	JK	PDW	MKB	21.10.14
No.	Amendments	Drawn	Design	Appd	Registered Engineer Reg No. Date

This drawing cannot be copied or reproduced in any form or used for any purpose other than that originally intended without the written permission of BMD Consulting Pty Ltd. © COPYRIGHT 2015



- CIVIL ENGINEERS
 - STRUCTURAL ENGINEERS
 - PROJECT MANAGERS
- ABN 28 010 748 882

Client	URBEX AND LAND DEVELOPMENT CORP. (JV)		
Project	ZUCCOLI STAGE 1 PHASE 2.4		
Title	COMBINED SERVICES PLAN		
Datum	AHD	PSM	
AS CONSTRUCTED	RL	(MGA) COORD	
Project No.	B00114-CSV401	Drawing No.	3